

WASH

Well Record

011140

STATE WELL NO. 15/4W 32(1)
COUNTY Washington
APPLICATION NO.

OWNER: Fred Lunge


MAILING ADDRESS:

LOCATION OF WELL: Owner's No.

CITY AND STATE:

..... 1/4 1/4 Sec. T. N. S., R. E. W., W.M.

Bearing and distance from section or subdivision corner

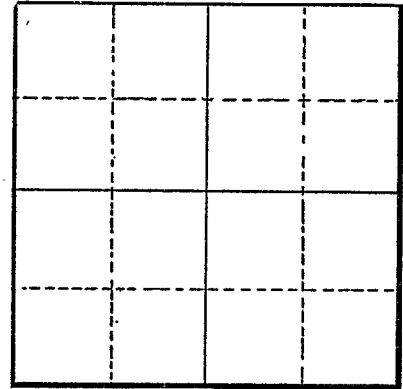

Section

Altitude at well 235 ft.

TYPE OF WELL: drilled Date Constructed

Depth drilled 112 ft. Depth cased 111 ft.

CASING RECORD: 6 inch.

FINISH:

AQUIFERS: Gravel from 109 to 112 ft.

WATER LEVEL: 30 ft. below land surface.

PUMPING EQUIPMENT: Type jet H.P.
Capacity G.P.M.

WELL TESTS:

Drawdown ft. after hours G.P.M.
Drawdown ft. after hours G.P.M.

USE OF WATER domestic & stock Temp. °F., 19.....

SOURCE OF INFORMATION J. L. S.

DRILLER or DIGGER

ADDITIONAL DATA:

Log Water Level Measurements Chemical Analysis Aquifer Test

REMARKS: Reportedly sand and clay entire depth to aquifer.