

STATE ENGINEER  
Salem, Oregon

**WASH** Well Record

STATE WELL NO. W. 550.11  
COUNTY Washington  
APPLICATION NO. 227

OWNER: Hulda M. Hanes 011324


MAILING ADDRESS: \_\_\_\_\_

LOCATION OF WELL: Owner's No. \_\_\_\_\_

CITY AND STATE: Gaston, Ore.

NE 1/4 NW 1/4 Sec. 35 T. 1 S., R. 4 W., W.M.

Bearing and distance from section or subdivision corner Apprx. 1780 ft. E. & 780 ft. S. From NW cor. of Sec. 35

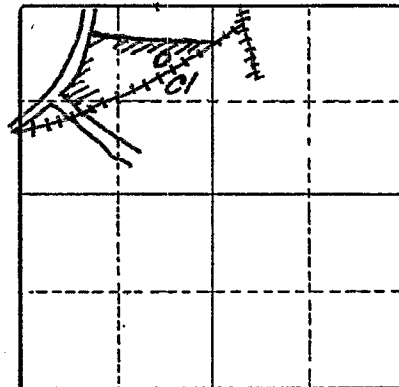

Altitude at well ?

TYPE OF WELL: Drilled Date Constructed June 1952

Depth drilled 83.5 Depth cased 83.5

Section 35

CASING RECORD:

6 inch OD

FINISH: \_\_\_\_\_

AQUIFERS: \_\_\_\_\_

WATER LEVEL:

6

PUMPING EQUIPMENT: Type Little Chief Turbine H.P. 5 HP  
Capacity 100 G.P.M.

WELL TESTS:

Drawdown \_\_\_\_\_ ft. after \_\_\_\_\_ hours \_\_\_\_\_ G.P.M.  
Drawdown \_\_\_\_\_ ft. after \_\_\_\_\_ hours \_\_\_\_\_ G.P.M.

USE OF WATER irrigation Temp. \_\_\_\_\_ °F., 19 \_\_\_\_\_

SOURCE OF INFORMATION Ground water registration records  
DRILLER or DIGGER A. J. Tyler of Wilcox Drilling Co. Mc Minnville

ADDITIONAL DATA:

Log \_\_\_\_\_ Water Level Measurements \_\_\_\_\_ Chemical Analysis \_\_\_\_\_ Aquifer Test \_\_\_\_\_

REMARKS: Clay to 60', streaks of sand to 83'