

STATE ENGINEER
Salem, Oregon

OBSERVATION WELL
WASH Well Record
011434


STATE WELL NO. 214-59(1)
COUNTY Wash.
APPLICATION NO. 64-597

OWNER: Leonard S. Davis MAILING ADDRESS: _____

LOCATION OF WELL: Owner's No. _____ CITY AND STATE: Tigard, Ore.

SW 1/4 SE 1/4 Sec. 3 T. 2 S., R. 1 W., W.M.

Bearing and distance from section or subdivision corner 522 ft. N. & 295 ft. E. of SW 1/4 cor. sec. 3

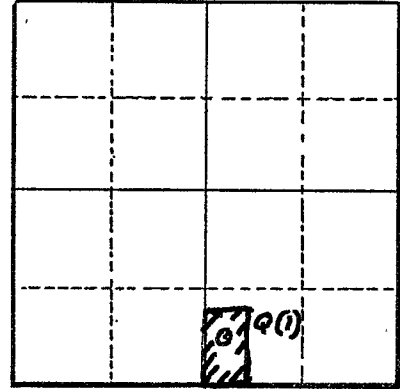

Altitude at well 270 feet

TYPE OF WELL: Drilled Date Constructed March 10-54

Depth drilled 218 Depth cased 164

Section 3

CASING RECORD:

6 inch

FINISH:

AQUIFERS:

WATER LEVEL:

185 feet

PUMPING EQUIPMENT: Type Sumo Submersible H.P. 7 1/2
Capacity 60 G.P.M.

WELL TESTS:

Drawdown _____ ft. after _____ hours _____ G.P.M.
Drawdown _____ ft. after _____ hours _____ G.P.M.

USE OF WATER irrigation-12 Temp. _____ °F., 19 _____

SOURCE OF INFORMATION 64-597

DRILLER or DIGGER _____

ADDITIONAL DATA:

Log _____ Water Level Measurements _____ Chemical Analysis _____ Aquifer Test _____

REMARKS: ↓

Clay --- 98 ft.
Sand --- 66 ft.