

STATE ENGINEER
Salem, Oregon

WASH Well Record
011442


STATE WELL NO. 25/144 480
COUNTY Washington
APPLICATION NO.

OWNER: R. Sunamoto MAILING ADDRESS:

LOCATION OF WELL: Owner's No. CITY AND STATE:

..... 1/4 1/4 Sec. T. N. E. S., R. W., W.M.

Bearing and distance from section or subdivision corner

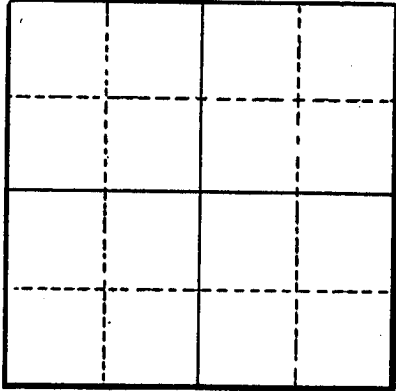

Section

Altitude at well 250 ft.

TYPE OF WELL: drilled Date Constructed

Depth drilled 385 ft. Depth cased

CASING RECORD: 8 inch.

FINISH:

AQUIFERS: Basalt.

WATER LEVEL: -

PUMPING EQUIPMENT: Type turbine H.P. Capacity G.P.M.

WELL TESTS: Drawdown ft. after hours G.P.M. Drawdown ft. after hours G.P.M.

USE OF WATER irrigation Temp. °F. 19

SOURCE OF INFORMATION D.S.S.

DRILLER or DIGGER

ADDITIONAL DATA: Log Water Level Measurements Chemical Analysis Aquifer Test

REMARKS: Reportedly encountered basalt from 135 to 385 ft.

STATE ENGINEER
Salem, Oregon

WASH Well Record
11442 011443

STATE WELL NO. 21W-4B(1)
COUNTY Washington
APPLICATION NO. GR-575


OWNER: Robert Sunamoto

MAILING ADDRESS: 120750 S.W. 135th Ave
CITY AND STATE: Portland 22, Ore

LOCATION OF WELL: Owner's No.

NW 1/4 NE 1/4 Sec. 4 T. 2 S., R. 1 W., W.M.

Bearing and distance from section or subdivision corner 1070 ft. S. & 2200 ft. W. from N.E. cor. sec. 4

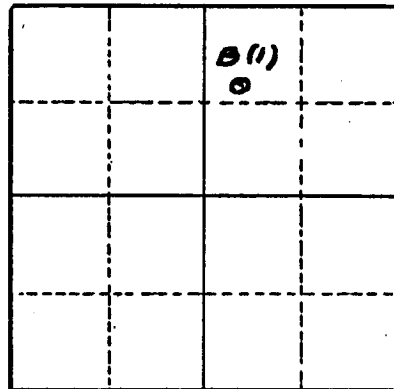

Section 4

Altitude at well 250

TYPE OF WELL: drilled Date Constructed 1953

Depth drilled 385 Depth cased

CASING RECORD:

8 inch

FINISH:

AQUIFERS:

WATER LEVEL:

70

PUMPING EQUIPMENT: Type Johnston H.P. 30
Capacity 250 G.P.M.

WELL TESTS:

Drawdown 120 ft. after hours 250 G.P.M.
Drawdown ft. after hours G.P.M.

USE OF WATER irrigation-57A. Temp. °F., 19

SOURCE OF INFORMATION GR-575
DRILLER or DIGGER Haakon Battner; Portland, Ore.

ADDITIONAL DATA:

Log Water Level Measurements Chemical Analysis Aquifer Test

REMARKS:

Dirt - - - 0' to 350'
Rock - - - 350' to 385'