

STATE ENGINEER
Salem, Oregon


WASH Well Record
011447

STATE WELL NO. 2/1-4F
COUNTY Washington
APPLICATION NO. GR-2636

OWNER: Reuben C. & Joyce V. Sandness MAILING ADDRESS: 13725 S.W. Fern

LOCATION OF WELL: Owner's No. CITY AND STATE: Tigard 23, Oregon

SE 1/4 NW 1/4 Sec. 4 T. 2 S., R. 1 W., W.M.
Bearing and distance from section or subdivision
corner 1930' E. & 980' N. from W corner Sec. 4

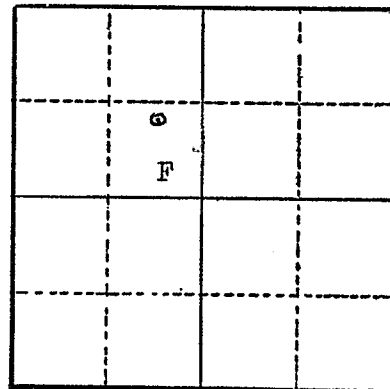

Section 4

Altitude at well 300'

TYPE OF WELL: Drilled. Date Constructed 1949

Depth drilled 178' Depth cased 63'

CASING RECORD:

6-inch

FINISH:

AQUIFERS:

WATER LEVEL:

145'

PUMPING EQUIPMENT: Type Red Jacket submersible H.P. 1 1/2
Capacity 16 G.P.M.

WELL TESTS:

Drawdown nil ft. after hours 16 G.P.M.

Drawdown ft. after hours G.P.M.

USE OF WATER Residence 1 acre garden Temp. °F. 19

SOURCE OF INFORMATION GR-3997

DRILLER or DIGGER

ADDITIONAL DATA:

Log NA Water Level Measurements Chemical Analysis Aquifer Test

REMARKS: