

STATE ENGINEER
Salem, Oregon

WASH Well Record
011510 GR-1481

STATE WELL NO. 2/1W-6E
COUNTY Washington
APPLICATION NO. GR-1538

OWNER: E. J. & R. E. Lindquist

MAILING ADDRESS: Rt. 1, Box 832


LOCATION OF WELL: Owner's No.

CITY AND STATE: Beaverton, Oregon

SW 1/4 NW 1/4 Sec. 6 T. 2 S, R. 1 W, W.M.

Bearing and distance from section or subdivision

corner N. 38° 27' E. 347' from SW cor. Sec. 6

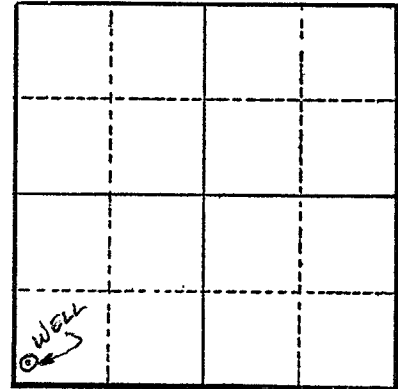

Section 6

Altitude at well

TYPE OF WELL: Drilled Date Constructed 1953

Depth drilled 544' Depth cased 29'

CASING RECORD:

8"

FINISH:

AQUIFERS:

WATER LEVEL:

88'

PUMPING EQUIPMENT: Type Johnson 4" turbine H.P. 10
Capacity 135 G.P.M.

WELL TESTS:

Drawdown 10 ft. after hours 300 G.P.M.

Drawdown ft. after hours G.P.M.

USE OF WATER Irrigation Temp. °F. 19

SOURCE OF INFORMATION GR Record

DRILLER or DIGGER Bill Sennett

ADDITIONAL DATA:

Log N.A. Water Level Measurements Chemical Analysis Aquifer Test

REMARKS:

Irrigation of 7 acres.