

STATE ENGINEER
Salem, Oregon

WASH
011513

Well Record

STATE WELL NO. 31W-6 R01
COUNTY Wash.
APPLICATION NO. GR-366

OWNER: Edward Roshak


MAILING ADDRESS: Rt. 4 Box 392

LOCATION OF WELL: Owner's No. _____

CITY AND STATE: Sherwood, Ore

SE 1/4 SE 1/4 Sec. 6 T. 2 S., R. 1 W., W.M.

Bearing and distance from section or subdivision
corner N. 63°54'W. 1200.81 ft.
from S.E. cor. Sec. 6

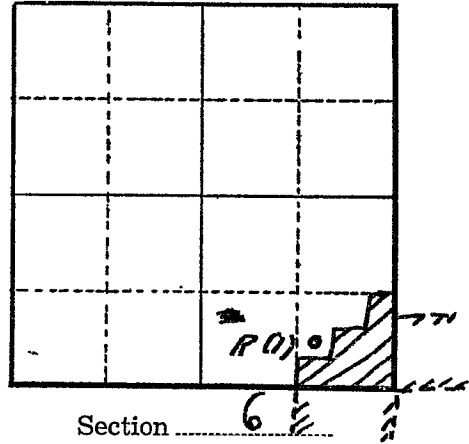

Altitude at well 265

TYPE OF WELL: Drilled Date Constructed Nov. '52

Depth drilled 232 Depth cased 92

CASING RECORD:

6 inch

FINISH:

AQUIFERS:

WATER LEVEL:

90

PUMPING EQUIPMENT: Type Peerless Centrifical H.P. 5
Capacity 70 G.P.M.

WELL TESTS:

Drawdown _____ ft. after _____ hours _____ G.P.M.
Drawdown _____ ft. after _____ hours _____ G.P.M.

USE OF WATER irrigation Temp. _____ °F., 19

SOURCE OF INFORMATION Ground Water Registration Record
DRILLER or DIGGER Wm. J. Stennat, Ore. City, Ore.

ADDITIONAL DATA:

Log No. Water Level Measurements _____ Chemical Analysis _____ Aquifer Test _____

REMARKS: