

STATE ENGINEER
Salem, Oregon

WASH
011570

Well Record

STATE WELL NO 2/IW - 10G
COUNTY WASHINGTON
APPLICATION NO. GR-2199

OWNER: J. V. Chandler


MAILING ADDRESS: P. O. Box 6344

LOCATION OF WELL: Owner's No.

CITY AND STATE: Tigard, Oregon

SW 1/4 NE 1/4 Sec. 10 T. 2 N. 1 E. S., R. 1 W., W.M.

Bearing and distance from section or subdivision corner 1700' S. and 2050' E.

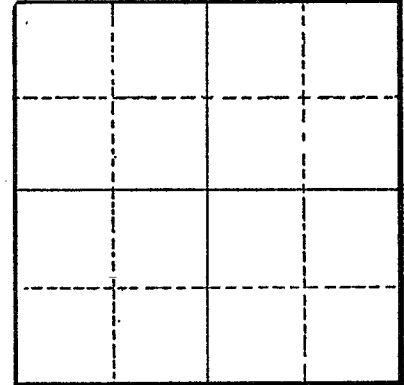

Section

Altitude at well

TYPE OF WELL: Drilled Date Constructed 1948

Depth drilled 183 Depth cased 6 26

CASING RECORD:

- 8-Inch
- 6-Inch
- 6-Inch

FINISH:

AQUIFERS:

WATER LEVEL:

90-Feet

PUMPING EQUIPMENT: Type Pomona Turbine H.P. 3
Capacity 50 G.P.M.

WELL TESTS:

Drawdown 55 ft. after hours Pumping 35 G.P.M.

Drawdown ft. after hours G.P.M.

USE OF WATER Industrial & Irrigation Temp. °F. 19

SOURCE OF INFORMATION GR-2104

DRILLER or DIGGER Harry Carsh, Tigard, Oregon

ADDITIONAL DATA:

Log Water Level Measurements Chemical Analysis Aquifer Test

REMARKS: