

STATE ENGINEER
Salem, Oregon

WASH Well Record
011578 GR- 1545


STATE WELL NO. 2/1W-10K
COUNTY Washington
APPLICATION NO. GR- 667

OWNER: William Bodman & Claire M. Sanders MAILING ADDRESS:

LOCATION OF WELL: Owner's No. CITY AND STATE: Tigard, Oregon

NW 1/4 SE 1/4 Sec. 10 T. 2 S., R. 1 W., W.M.

Bearing and distance from section or subdivision corner 1950' N. & 1560' W. from SE cor. Sec. 10.

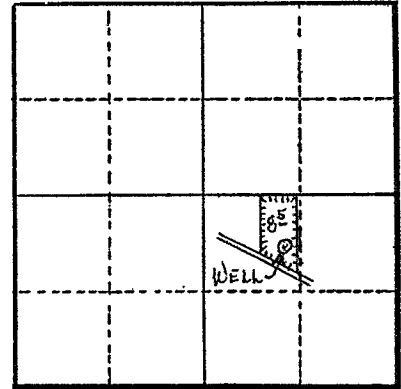

Section 10

Altitude at well 290'

TYPE OF WELL: Drilled Date Constructed 1951

Depth drilled 125' Depth cased 20'

CASING RECORD:

8"

FINISH:

AQUIFERS:

WATER LEVEL:

70'

PUMPING EQUIPMENT: Type Dorrard jet H.P. 2

Capacity 20 G.P.M.

WELL TESTS:

Drawdown 25 ft. after 28 hours G.P.M.

Drawdown ft. after hours G.P.M.

USE OF WATER Irrigation Temp. °F. 19

SOURCE OF INFORMATION GR Record

DRILLER or DIGGER Klundt Bros.

ADDITIONAL DATA:

Log Water Level Measurements Chemical Analysis Aquifer Test

REMARKS:

Log: Clay 0 to 10 ft.
Soft rock 10 to 20 ft.
Hard rock 20 to 125 ft.

Irrigation of 8.5 acres.