

STATE ENGINEER
Salem, Oregon

WASH
011599

Well Record

GR- 1499

STATE WELL NO. 2/1W-11B
COUNTY Washington
APPLICATION NO. GR- 1555


OWNER: George L. Penrose

MAILING ADDRESS: 9280 SW Mt. View Lane

LOCATION OF WELL: Owner's No.

CITY AND STATE: Tigard, Oregon

NW 1/4 NE 1/4 Sec. 11 T. 2 S., R. 1 W., W.M.

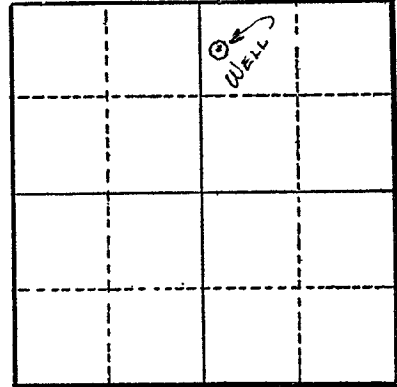

Bearing and distance from section or subdivision corner 660' N. & 2376' E. to NE cor. Sec. 11

Section 11

Altitude at well 100'

TYPE OF WELL: Drilled Date Constructed 1953

Depth drilled 200' Depth cased 37'

CASING RECORD:

8"

FINISH:

AQUIFERS:

WATER LEVEL:

165'

PUMPING EQUIPMENT: Type Deep well turbine H.P. 5
Capacity 64 G.P.M.

WELL TESTS:

Drawdown 10 ft. after 78 hours G.P.M.
Drawdown ft. after hours G.P.M.

USE OF WATER Irrigation Temp. °F. 19

SOURCE OF INFORMATION GR Record

DRILLER or DIGGER Stienman Bros.

ADDITIONAL DATA:

Log N.A. Water Level Measurements Chemical Analysis Aquifer Test

REMARKS:

Irrigation of 10 acres.