

STATE ENGINEER
Salem, Oregon

WASH
011606

OBSERVATION WELL
Well Record

STATE WELL NO. 2/W-11 M.O.
COUNTY Washington
APPLICATION NO. GR-131

OWNER: Walter H. & Hazel Pearl Engler

MAILING
ADDRESS:

LOCATION OF WELL: Owner's No. 1


CITY AND
STATE:

Tigard, Oregon

NW 1/4 SW 1/4 Sec. 11 T. 2 S., R. 1 W., W.M.

Bearing and distance from section or subdivision

corner 392 feet north and 459 feet east
to corner of Marguerite Oaks Tract
or 400 South and 700 feet from west 1/4 corner
section 11.

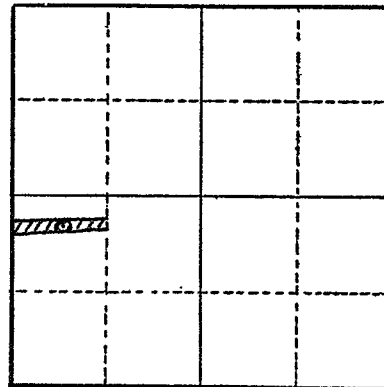

Section 11

Altitude at well 275 feet Interpolated

TYPE OF WELL: Drilled Date Constructed 2/5/53

Depth drilled 262 Depth cased 108

CASING RECORD:

6 — inch steel casing set from 0 to 108 feet. [Rock 108 to 262]

FINISH:

NONE

AQUIFERS:

UNKNOWN

WATER LEVEL:

100 feet below land surface Summer 1953

PUMPING EQUIPMENT: Type

H.P.

Capacity G.P.M.

WELL TESTS:

Drawdown 0? ft. after 3.5 hours G.P.M.

Drawdown ft. after hours G.P.M.

USE OF WATER Irrigation 3.5 acres Temp. °F., 19

SOURCE OF INFORMATION Registration Statement GR-131

DRILLER or DIGGER L.W. Strayer Rt. 1 Box 450 Beaverton, Oregon

ADDITIONAL DATA:

Log NO Water Level Measurements Chemical Analysis Aquifer Test

REMARKS: