

STATE ENGINEER
Salem, Oregon

WASH 011607 Well Record


STATE WELL NO. 2/1w-11 M(2)
COUNTY Washington
APPLICATION NO. GR-132

OWNER: Howard William & Marilyn K. Boyte MAILING ADDRESS: Rt 2, Box 19

LOCATION OF WELL: Owner's No. 1 CITY AND STATE: Tigard, Oregon

NW 1/4 SW 1/4 Sec. 11 T. 2 S., R. 1 W., W.M.

Bearing and distance from section or subdivision corner East 566 feet of Lot #1 Macchords Tract.

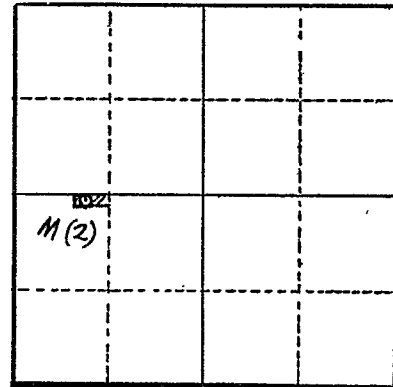

Section 11

Altitude at well 275 feet Interpolated

TYPE OF WELL: Drilled Date Constructed Dec. 1952

Depth drilled 162 Depth cased 30

CASING RECORD:

6 — inch steel casing set from 0 to 30 feet. [Rock 30 to 162 ft.]

FINISH:

none

AQUIFERS:

unknown

WATER LEVEL:

110 feet below land surface 2/28/53

PUMPING EQUIPMENT: Type Sumo TCL 315 H.P. 2
Capacity 10.44 G.P.M.

WELL TESTS:

Drawdown 0? ft. after _____ hours 18 G.P.M.
Drawdown _____ ft. after _____ hours _____ G.P.M.

USE OF WATER Irrigation 2.2 acres Temp. _____ °F. _____, 19____

SOURCE OF INFORMATION Registration Statement GR-132

DRILLER or DIGGER Lance W. Strayer Rt. 1 Box 450 Beaverton, Oregon

ADDITIONAL DATA:

Log NO Water Level Measurements _____ Chemical Analysis _____ Aquifer Test _____

REMARKS: