

STATE ENGINEER
Salem, Oregon

WASH
011621

Well Record

STATE WELL NO. 2/1W-12K
COUNTY Washington
APPLICATION NO. GR-3810


OWNER: William Clifford VanCott

MAILING ADDRESS: 15455 SW 72nd Ave.

LOCATION OF WELL: Owner's No. _____

CITY AND STATE: Tigard 23, Oregon

NW 1/4 SE 1/4 Sec. 12 T. 2 S., R. 1 W., W.M.

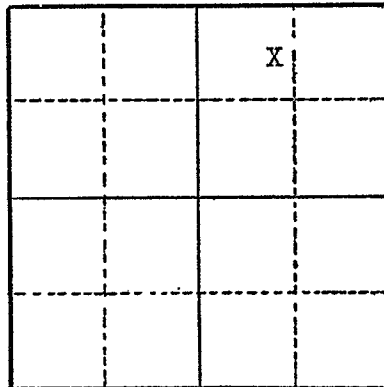

Bearing and distance from section or subdivision corner 1400' W. & 1470' N. from SE Cor. Sec. 12

Altitude at well _____

TYPE OF WELL: Dug Date Constructed 9/11/51

Depth drilled 29 feet Depth cased _____

Section 12

CASING RECORD:

FINISH:

AQUIFERS:

WATER LEVEL:

12 feet below surface

PUMPING EQUIPMENT: Type Pacific Pump H.P. 1/2
Capacity 15 G.P.M.

WELL TESTS:

Drawdown 7.5 ft. after _____ hours 8.5 G.P.M.
Drawdown 14 ft. after _____ hours 14.2 G.P.M.

USE OF WATER Irrigation Temp. _____ °F., 19

SOURCE OF INFORMATION Well Registration Statement

DRILLER or DIGGER Charles Myers

ADDITIONAL DATA:

Log _____ Water Level Measurements _____ Chemical Analysis _____ Aquifer Test _____

REMARKS: