

STATE ENGINEER
Salem, Oregon

WASH Well Record
011678


STATE WELL NO. 2/lw-13L 1
COUNTY WASHINGTON
APPLICATION NO. GR. 22-59, GR. 2150

OWNER: Henry S. Mears MAILING ADDRESS: 17015 SW Upper Boone Ferry, Ra

LOCATION OF WELL: Owner's No. _____ CITY AND STATE: Tigard

NE $\frac{1}{4}$ SW $\frac{1}{4}$ Sec. 13 T. 2 N. S., R. 1 E. W., W.M.

Bearing and distance from section or subdivision corner N49°40'E. 347.6' to the Center of Section 13 from the well

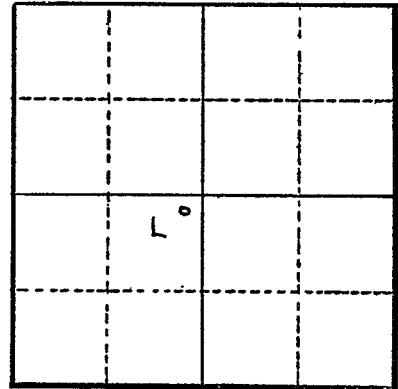

Section 13

Altitude at well _____

TYPE OF WELL: Drilled Date Constructed 1941

Depth drilled 120 Depth cased 120

CASING RECORD:

8-inch

FINISH:

Casing perforated

AQUIFERS:

Loose gravel from 80 to 105 feet.

WATER LEVEL:

80 feet below land surface.

PUMPING EQUIPMENT: Type Pomona H.P. 3
Capacity 30 G.P.M.

WELL TESTS:

Drawdown 6 ft. after _____ hours Pumping 250 G.P.M.
Drawdown _____ ft. after _____ hours _____ G.P.M.

USE OF WATER Irrigation Temp. _____ °F. _____, 19_____

SOURCE OF INFORMATION GR. 2259

DRILLER or DIGGER Steinman Bros.

ADDITIONAL DATA:

Log Water Level Measurements _____ Chemical Analysis _____ Aquifer Test _____

REMARKS:

