

STATE ENGINEER
Salem, Oregon

WASH
011680

Well Record

STATE WELL NO. 2/1W-13Q
COUNTY WASHINGTON
APPLICATION NO. GR-3010

OWNER: Ben Brehm


MAILING ADDRESS: 18069 Lower Boones Ferrey Rd

LOCATION OF WELL: Owner's No.

CITY AND STATE: Washington

SW 1/4 SE 1/4 Sec. 13 T. 2 S., R. 1 W., W.M.

Bearing and distance from section or subdivision
corner 2230' S & 400' E from cor of sec 13

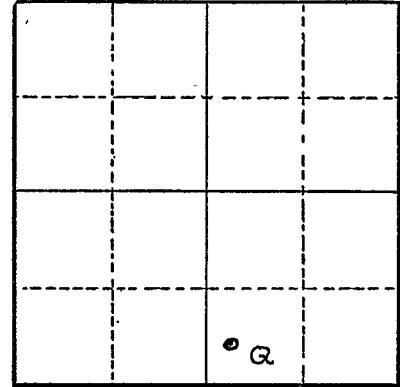

Section 13

Altitude at well

TYPE OF WELL: Drilled Date Constructed 1948

Depth drilled 91' Depth cased 91'

CASING RECORD:

6-inch

FINISH:

AQUIFERS:

WATER LEVEL:

56'

PUMPING EQUIPMENT: Type Montgomery Ward - Jet

H.P. 1

Capacity 12 1/2 G.P.M.

WELL TESTS:

Drawdown 5 ft. after 15 1/3 hours G.P.M.

Drawdown ft. after hours G.P.M.

USE OF WATER Irrigation Temp. °F., 19

SOURCE OF INFORMATION GR-3945

DRILLER or DIGGER Sam Munson

ADDITIONAL DATA:

Log NA Water Level Measurements Chemical Analysis Aquifer Test

REMARKS: