

ORIGINAL
File Original and
Duplicate with the
STATE ENGINEER,
SALEM, OREGON

WASH WATER WELL DRILLERS REPORT
011690 STATE OF OREGON

Do Not
File In State Well No. 2/1W-13 D
GR-2615-APP
State Permit No. GR-2615 OR

(1) OWNER:
Name Washington Co. School Dist #82
Address 8040 SW Dulles Road,
Tigard #29, Ore.

(2) LOCATION OF WELL:
County Washington Owner's number, if any—
R. F. D. or Street No.
Bearing and distance from section or subdivision corner
N 45° E 100' dist to SW corner of lot 4.
Dunkum Area, NW 1/4 NW 1/4
1000' E of 300' S corner of Sect. 13

(3) TYPE OF WORK (check): Reg. Statement
New well Deepening Reconditioning Abandon
Abandonment, describe material and procedure in Item 11.

(4) PROPOSED USE (check):
Domestic Industrial Municipal
Irrigation Test Well Other

(5) EQUIPMENT:
Rotary
Cable
Dug Well

(6) CASING INSTALLED:

FROM	ft. to	ft.	Diam.	Gage or Wall	Diameter of Bore	from ft.	to ft.
" 0 "	" 150 "	" "	" 6 "	" "	" "	" "	" "
" "	" "	" "	" "	" "	" "	" "	" "
" "	" "	" "	" "	" "	" "	" "	" "
" "	" "	" "	" "	" "	" "	" "	" "
" "	" "	" "	" "	" "	" "	" "	" "

Type and size of shoe or well ring _____
Describe joint _____

(7) PERFORATIONS:

SIZE of perforations	in. length, by	in.
FROM ft. to	ft.	part per foot
" 110 "	" 147 "	" ? "
" "	" "	" "
" "	" "	" "
" "	" "	" "
" "	" "	" "

SCREENS:
Give Manufacturer's Name, Model No. and Size

(8) CONSTRUCTION:
Was a surface sanitary seal provided? Yes No To what depth _____ ft.
Were any strata sealed against pollution? Yes No
If yes, note depth of strata _____
FROM _____ ft. to _____ ft.

METHOD OF SEALING

(9) WATER LEVELS:
Depth at which water was first found _____ ft.
Standing level before perforating _____ ft.
Standing level after perforating _____ ft.
Log Accepted by: _____
[Signed] _____ Owner Dated _____, 19____

(10) WELL TESTS: Pg 1 of 3
Was a pump test made? Yes No If yes, by whom?
Yield: 17 gal./min. with _____ ft. draw down after _____ hrs.
Artesian flow _____ g.p.m.
Shut-in pressure _____ lbs. per square inch.
Boffer test _____ g.p.m. with _____ ft. drawdown
Temperature of water _____ Was a chemical analysis made? Yes No
Was electric log made of well? Yes No.

(11) WELL LOG:

Diameter of well, 6 inches.
Total depth 200 ft. Depth of completed well 150 ft.

Formation: Describe by color, character, size of material and structure, and show thickness of aquifers and the kind and nature of the material in each stratum penetrated, with at least one entry for each change of formation.

ft. to	ft.	
0	8	Brown silt
8	64	" Sand
64	74	Clay blue, very sticky
74	95	silt, brown & blue
95	105	Clay, blue sticky
105	120	Silt, brown & blue
120	125	Silt, brown
125	140	Silt, blue - sand & water bearing - mica
140	150	Shale, blue
150	200	Shale, blue clay, sandy layers

Ground elevation at well site _____ feet above mean sea level.
Work started July 12, 1951 Completed Aug 1951

Well Driller's Statement:
This well was drilled under my jurisdiction and this report is true to the best of my knowledge and belief.

NAME Unk. (Person, firm, or corporation) (Typed or printed)
Address _____
Driller's well number _____
[Signed] _____ (Well Driller)
License No. _____ Dated _____, 19____

STATE ENGINEER
Salem, Oregon

WASH
011690

Well Record

B 2 of 3

STATE WELL NO. 2/W-13
COUNTY WASHINGTON
APPLICATION NO. GR-2764

OWNER: Washington Co. School Dist. #82
by Esther C. Belkington, clerk
MAILING ADDRESS: 8040 S.W. Durham Road
CITY AND STATE: Tigard 23, Oregon

LOCATION OF WELL: Owner's No. _____


NE 1/4 NW 1/4 Sec. 13 T. 2 N. S., R. 1 W., W.M.

Bearing and distance from section or subdivision corner N. 45° E. 100' to SW corner Lot 4 Durham Acres

Altitude at well _____

TYPE OF WELL: drilled Date Constructed 1951

Depth drilled 150 Depth cased 150

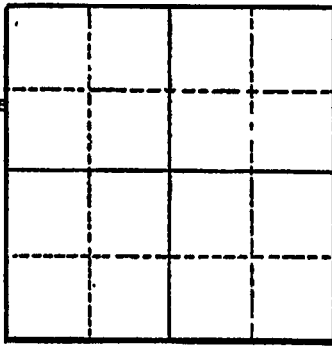

Section _____

CASING RECORD:

6-inch

FINISH:

From 110 to 147

AQUIFERS:

Silt, sand, clay and shale

WATER LEVEL:

PUMPING EQUIPMENT: Type Doxwald Ejector H.P. 1 1/2
Capacity 12 G.P.M.

WELL TESTS:
Drawdown _____ ft. after _____ hours Pumping 17 G.P.M.
Drawdown _____ ft. after _____ hours _____ G.P.M.

USE OF WATER Domestic & irrigation Temp. °F. 19

SOURCE OF INFORMATION GR-2615

DRILLER or DIGGER _____

ADDITIONAL DATA:
Log Water Level Measurements _____ Chemical Analysis _____ Aquifer Test _____

REMARKS:

