

STATE ENGINEER  
Salem, Oregon

**WASH** Well Record  
011707

STATE WELL NO. *25110 14AG*  
COUNTY *Washington*  
APPLICATION NO. \_\_\_\_\_

OWNER: *Tigard Senior High School* MAILING ADDRESS: \_\_\_\_\_

LOCATION OF WELL: Owner's No. \_\_\_\_\_ CITY AND STATE: \_\_\_\_\_

\_\_\_\_\_ 1/4 \_\_\_\_\_ 1/4 Sec. \_\_\_\_\_ T. \_\_\_\_\_ N. \_\_\_\_\_ E. \_\_\_\_\_ S., R. \_\_\_\_\_ W., W.M.


Bearing and distance from section or subdivision corner \_\_\_\_\_

Altitude at well *190 ft.*

TYPE OF WELL: *drilled* Date Constructed \_\_\_\_\_

Depth drilled *680 ft.* Depth cased *664 ft.*

CASING RECORD: *10 inch*

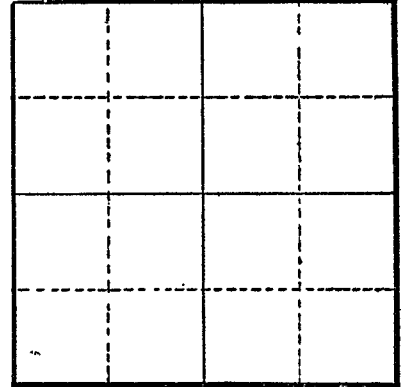

Section \_\_\_\_\_

FINISH: \_\_\_\_\_

AQUIFERS: *Basalt from 667 to 690 ft.*

WATER LEVEL: *7 ft. below land surface.*

PUMPING EQUIPMENT: Type *Turbine* H.P. \_\_\_\_\_  
Capacity \_\_\_\_\_ G.P.M.

WELL TESTS:  
Drawdown \_\_\_\_\_ ft. after \_\_\_\_\_ hours \_\_\_\_\_ G.P.M.  
Drawdown \_\_\_\_\_ ft. after \_\_\_\_\_ hours \_\_\_\_\_ G.P.M.

USE OF WATER *public supply* Temp. \_\_\_\_\_ °F. \_\_\_\_\_, 19\_\_\_\_\_

SOURCE OF INFORMATION *U.S.G.S.*

DRILLER or DIGGER \_\_\_\_\_

ADDITIONAL DATA:  
Log  Water Level Measurements \_\_\_\_\_ Chemical Analysis \_\_\_\_\_ Aquifer Test \_\_\_\_\_

REMARKS: *see table 2 for log.*

STATE ENGINEER  
Salem, Oregon

State Well No. 25/w. 14A(C)

County Wash.

Application No. \_\_\_\_\_

Janssen  
Drilled this  
well to 250'

## Well Log

Owner: Tigard Senior High School Owner's No. \_\_\_\_\_

Driller: Steinman Bros. Drilling Co. Date Drilled 1953

CHARACTER OF MATERIAL	(Feet below land surface)		Thickness (feet)
	From	To	
Valley Fill:		-	-
Clay & sand		18	18
" , yellow & blue		66	48
" , blue & sand, yellow		116	50
" , " , gray		150	34
" & "Quicksand"		190	40
" , blue		242	52
Sand & gravel		244	2
clay, blue-gray		260	16
sand, water-bearing		261	1
Clay, blue-gray		324	63
" , yellow		341	17
" , blue		350	9
" , brown		360	10
" , blue		378	18
"Shale," blue-gray		384	6
Clay, blue		430	46
" , brown		437	7
One g.p.m. with rotten wood in water		437	-
Clay & weathered gravel		445	8
" , blue-gray		477	32
" , brown "gritty"		479	2
" , gray		512	33
" , "chocolate"-brown		528	16

