

STATE ENGINEER  
Salem, Oregon

WASH  
011708

Well Record

STATE WELL NO. 2/1W-14B  
COUNTY WASHINGTON  
APPLICATION NO. GR-2832

OWNER: Union High School No. 2 Jt.,  
Washington County, Oregon


MAILING ADDRESS: Tigard, Oregon

LOCATION OF WELL: Owner's No.

CITY AND STATE:

NW 1/4 NE 1/4 Sec. 14 T. 2 N. S, R. 1 E. W., W.M.

Bearing and distance from section or subdivision corner 375' S. and 425' E.

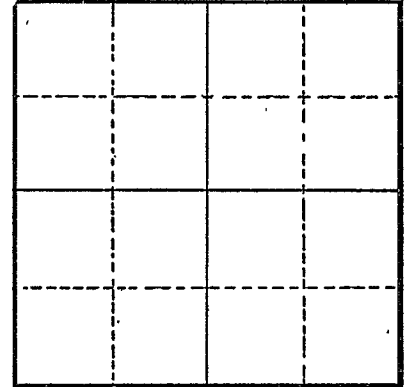

Section

Altitude at well

TYPE OF WELL: drilled Date Constructed 1952

Depth drilled 680 Depth cased 664

CASING RECORD:

10-inch

FINISH:

AQUIFERS:

WATER LEVEL:

PUMPING EQUIPMENT: Type Sump Sumo H.P. 10  
Capacity 80 G.P.M.

WELL TESTS:  
Drawdown 232 ft. after hours Pumping 40 G.P.M.  
Drawdown ft. after hours G.P.M.

USE OF WATER school use, irrigation Temp. °F. 19

SOURCE OF INFORMATION GR-2669

DRILLER or DIGGER

ADDITIONAL DATA:  
Log Water Level Measurements Chemical Analysis Aquifer Test

REMARKS: