

STATE ENGINEER  
Salem, Oregon

WASH  
011715

# Well Record

GR-1735

STATE WELL NO. 2/1W-14N  
COUNTY Washington  
APPLICATION NO. GR-1736

OWNER: George L. Hansen

MAILING

ADDRESS: Rt. 4, Box 146


LOCATION OF WELL: Owner's No.

CITY AND

STATE: Tualatin, Oregon

SW 1/4 SW 1/4 Sec. 14 T. 2 S., R. 1 W., W.M.

Bearing and distance from section or subdivision  
corner 300' N. & 50' W. from SE cor. of Lot 1 of  
Hazelbrook Farm

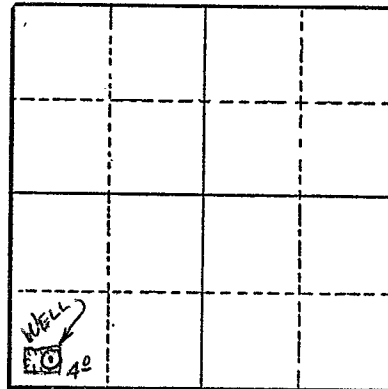

Section 14

Altitude at well 150'

TYPE OF WELL: Dug Date Constructed 1952

Depth drilled 46' Depth cased 46'

### CASING RECORD:

36" circular brick walled

### FINISH:

### AQUIFERS:

Gravel

### WATER LEVEL:

42'

PUMPING EQUIPMENT: Type Myers jet 2" x 1 1/2" H.P. 1 1/2  
Capacity 20 G.P.M.

### WELL TESTS:

Drawdown 0 ft. after hours 25 G.P.M.  
Drawdown ft. after hours G.P.M.

USE OF WATER Irrigation Temp. °F., 19

SOURCE OF INFORMATION GR Record

DRILLER or DIGGER

### ADDITIONAL DATA:

Log N.A. Water Level Measurements Chemical Analysis Aquifer Test

### REMARKS:

Irrigation of 4 acres.