

STATE ENGINEER  
Salem, Oregon

WASH  
011872 Well Record

STATE WELL NO. 25/1.w. 17861  
COUNTY Washington  
APPLICATION NO.

OWNER: T. Hasuike


MAILING  
ADDRESS:

LOCATION OF WELL: Owner's No.

CITY AND  
STATE:

1/4 1/4 Sec. T. N. E.  
S, R. W., W.M.

Bearing and distance from section or subdivision  
corner

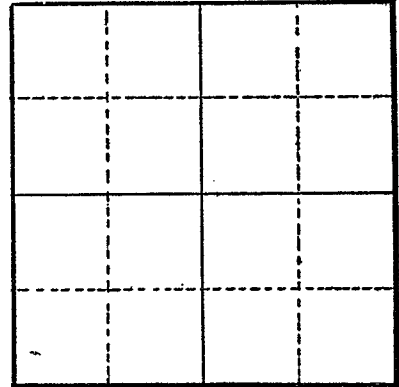

Section

Altitude at well 275 ft.

TYPE OF WELL: drilled Date Constructed

Depth drilled 293 ft. Depth cased 12 ft.

CASING RECORD: 12 inch.

FINISH:

AQUIFERS: Basalt.

WATER LEVEL: 218 ft. below land surface.

PUMPING EQUIPMENT: Type Turbine H.P.  
Capacity G.P.M.

WELL TESTS:  
Drawdown ft. after hours G.P.M.  
Drawdown ft. after hours G.P.M.

USE OF WATER irrigation Temp. °F., 19

SOURCE OF INFORMATION U.S.G.S.

DRILLER or DIGGER

ADDITIONAL DATA:

Log Water Level Measurements Chemical Analysis Aquifer Test

REMARKS: plans to irrigate about 30 acres of berries  
and vegetables; encountered basalt at 8 ft.