

STATE ENGINEER
Salem, Oregon

WASH
011875

OBSERVATION WELL
Well Record

STATE WELL NO. 25/111 1875
COUNTY Washington
APPLICATION NO.

OWNER: James Hasuike


MAILING ADDRESS:

LOCATION OF WELL: Owner's No.

CITY AND STATE:

1/4 1/4 Sec. T. N. S, R. E. W., W.M.

Bearing and distance from section or subdivision corner

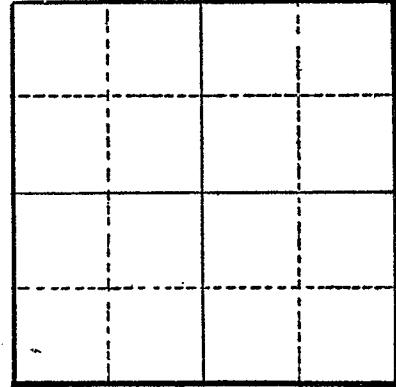

Section

Altitude at well 140 ft.

TYPE OF WELL: drilled Date Constructed

Depth drilled 161 ft. Depth cased 48 ft.

CASING RECORD: 10 inch

FINISH:

AQUIFERS: Basalt

WATER LEVEL: 41 ft. below land surface.

PUMPING EQUIPMENT: Type Turbine H.P.
Capacity G.P.M.

WELL TESTS:
Drawdown ft. after hours G.P.M.
Drawdown ft. after hours G.P.M.

USE OF WATER irrigation Temp. °F., 19

SOURCE OF INFORMATION U.S.G.S.

DRILLER or DIGGER

ADDITIONAL DATA:

Log Water Level Measurements Chemical Analysis Aquifer Test

REMARKS: Used for irrigating about 20 acres of berries and vegetables;
struck basalt at 40 ft.