

STATE ENGINEER  
Salem, Oregon

# WASH Well Record

011939

STATE WELL NO. 2/LW-22J  
COUNTY WASHINGTON  
APPLICATION NO. GR-2589

OWNER: Elmer Boge


MAILING ADDRESS: Rt. 2, Box 368

LOCATION OF WELL: Owner's No.

CITY AND STATE: Cornelius, Oregon

NE 1/4 SE 1/4 Sec. 22 T. 2 S., R. 1 W., W.M.

Bearing and distance from section or subdivision corner  
W. 78 rods, N. 90 rods, W. 8 Rods

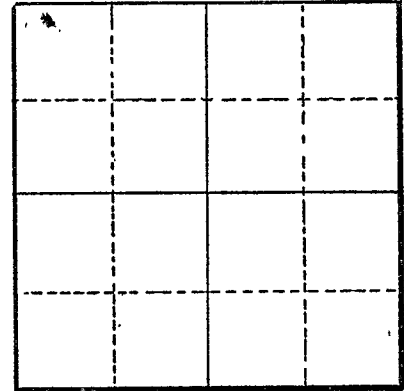

Section

Altitude at well

TYPE OF WELL: Dug Date Constructed 1951

Depth drilled 18 Depth cased

CASING RECORD:

33-inch

FINISH:

AQUIFERS:

WATER LEVEL:  
2-feet

PUMPING EQUIPMENT: Type Montgomery Ward H.P. 10  
Capacity 495 G.P.M.

WELL TESTS:  
Drawdown 10 ft. after hours Pumping 60 G.P.M.  
Drawdown ft. after hours G.P.M.

USE OF WATER Irrigation Temp. °F. 19

SOURCE OF INFORMATION GR-2456

DRILLER or DIGGER

ADDITIONAL DATA:

Log Water Level Measurements Chemical Analysis Aquifer Test

REMARKS: