

STATE ENGINEER  
Salem, Oregon

WASH Well Record  
011940


STATE WELL NO. 2/1W-22L  
COUNTY Washington  
APPLICATION NO. GR-3423

OWNER: R. M. and/or Josephine Bennett MAILING ADDRESS: Route 1, Box 187

LOCATION OF WELL: Owner's No. CITY AND STATE: Sherwood, Oregon

NE 1/4 SW 1/4 Sec. 22 T. 2 N. S, R. 1 W., W.M.

Bearing and distance from section or subdivision corner 1760.32' N. 89°48' E.

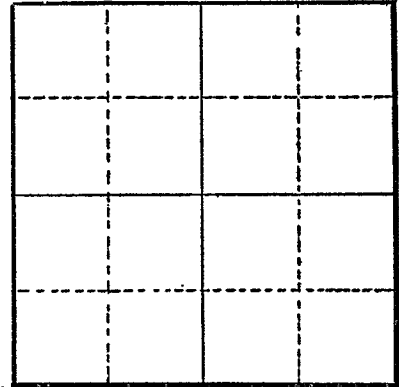

Section

Altitude at well

TYPE OF WELL: dug Date Constructed 1951

Depth drilled 9'9" Depth cased

CASING RECORD:

29"

FINISH:

AQUIFERS:

shot soil, sand, gravel

WATER LEVEL:

5'4"

PUMPING EQUIPMENT: Type Fairbanks Morse Cent. H.P. 1/4  
Capacity G.P.M.

WELL TESTS:

Drawdown little ft. after hours pumping 75 G.P.M.  
Drawdown 9" ft. after hours G.P.M.

USE OF WATER Irrigation Temp. °F., 19

SOURCE OF INFORMATION GR-3167

DRILLER or DIGGER

ADDITIONAL DATA:

Log  Water Level Measurements Chemical Analysis Aquifer Test

REMARKS:

shot soil 9'  
last 9" coarse sand and small washed gravel 9'9"