

STATE ENGINEER  
Salem, Oregon

WASH Well Record  
011942

STATE WELL NO. 2/IW-22P  
COUNTY WASHINGTON  
APPLICATION NO. GR-2745

OWNER: Charles O. Carlberg

MAILING ADDRESS:

Rt. 4, Box 188


LOCATION OF WELL: Owner's No.

CITY AND STATE:

Sherwood, Oregon

SE 1/4 SW 1/4 Sec. 22 T. 2 S., R. 1 W., W.M.

Bearing and distance from section or subdivision corner 1490' E. and 1215' N.

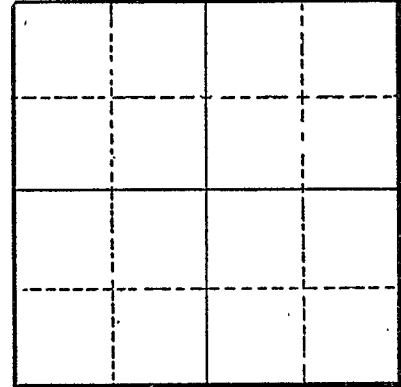

Section

Altitude at well

TYPE OF WELL: dug Date Constructed 1944

Depth drilled 12 Depth cased

CASING RECORD:

FINISH:

AQUIFERS:

WATER LEVEL:

5-feet

PUMPING EQUIPMENT: Type Fairbanks Morse

H.P. 5

Capacity 100 G.P.M.

WELL TESTS:

Drawdown 1 ft. after hours Pumping 100 G.P.M.

Drawdown ft. after hours G.P.M.

USE OF WATER irrigation Temp. °F., 19

SOURCE OF INFORMATION GR-2597

DRILLER or DIGGER

ADDITIONAL DATA:

Log Water Level Measurements Chemical Analysis Aquifer Test

REMARKS: