

STATE ENGINEER  
Salem, Oregon

WASH Well Record  
011961

STATE WELL NO. 2/14-23N0  
COUNTY Wash.  
APPLICATION NO. 61-362

OWNER: Geo. G. & Home Kagiso

MAILING ADDRESS: Rt. 1 Box 29

LOCATION OF WELL: Owner's No.

CITY AND STATE: Sherwood, Ore.

SW 1/4 SW 1/4 Sec. 23 T. 2 S., R. 1 W., W.M.


Bearing and distance from section or subdivision

corner Approx. 100 Ft. E. of W. line of Sec 23 & Approx. 75' N. of N. line the Tract in Sherwood Road CR # 492

Altitude at well 150

TYPE OF WELL: Drilled Date Constructed 1927 or 1928

Depth drilled 125 Depth cased 65

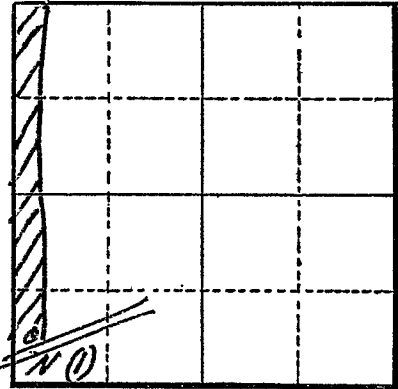

Section 23

CASING RECORD:

6 inch

FINISH:

AQUIFERS:

WATER LEVEL:

1 ft.

PUMPING EQUIPMENT: Type Jacuzzi

H.P. 3

Capacity 42 G.P.M.

WELL TESTS:

Drawdown ..... ft. after ..... hours ..... G.P.M.

Drawdown ..... ft. after ..... hours ..... G.P.M.

USE OF WATER irrigation Temp. °F. 19

SOURCE OF INFORMATION Ground Water Registration Record

DRILLER or DIGGER Mr. Olsen, Gresham

ADDITIONAL DATA:

Log No. Water Level Measurements Chemical Analysis Aquifer Test

REMARKS: