

STATE ENGINEER
Salem, Oregon

WASH Well Record

STATE WELL NO. 2/1W-24C
COUNTY Washington
APPLICATION NO. GR-1625

OWNER: George D. Ward


MAILING ADDRESS: 18230 SW Boones Ferry Rd.

LOCATION OF WELL: Owner's No.

CITY AND STATE: Tigard, Oregon

NE 1/4 NW 1/4 Sec. 24 T. 2 S., R. 1 W., W.M.

Bearing and distance from section or subdivision corner 190' W. & 20' S. from NE cor. of Property being Tax Lot #2J.

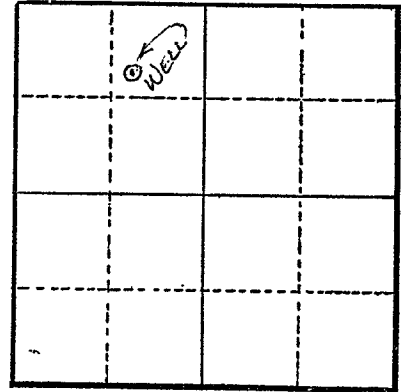

Section 24

Altitude at well 200'

TYPE OF WELL: Drilled Date Constructed 1955

Depth drilled 70' 10" Depth cased 40'

CASING RECORD:

6"

FINISH:

AQUIFERS:

WATER LEVEL:

20'

PUMPING EQUIPMENT: Type Myers Submersible H.P. 1/2
Capacity 20 G.P.M.

WELL TESTS:

Drawdown 0 ft. after 15 hours G.P.M.

Drawdown ft. after hours G.P.M.

USE OF WATER Irrigation Temp. °F. 19

SOURCE OF INFORMATION GR Record

DRILLER or DIGGER Steinman Bros.

ADDITIONAL DATA:

Log Water Level Measurements Chemical Analysis Aquifer Test

REMARKS:

Log: Sandy loam 0 to 9 ft.
Gravel 9 to 71 ft.

Irrigation of 1 acre.