

STATE ENGINEER
Salem, Oregon

WASH Well Record

STATE WELL NO. 2/IW-27
COUNTY WASHINGTON
APPLICATION NO. GR-2668


012065

OWNER: Loren Alvin Long
MAILING ADDRESS: Rt. 2, Box 122,

LOCATION OF WELL: Owner's No. ...
CITY AND STATE: Sherwood, Oregon

SE 1/4 SE 1/4 Sec. 27 T. 2 S. R. 1 W., W.M.

Bearing and distance from section or subdivision corner
Approximately 375' N. and 170' W.

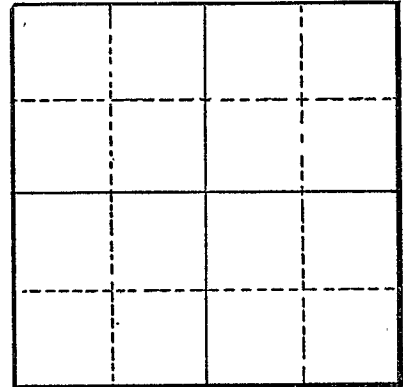

Section

Altitude at well

TYPE OF WELL: Drilled Date Constructed 1943

Depth drilled 102 Depth cased 55.25

CASING RECORD:

6-inch

FINISH:

AQUIFERS:

Hard pan, rock and clay

WATER LEVEL:

30-feet

PUMPING EQUIPMENT: Type Centrifugal & Jet H.P. 1
Capacity 15 G.P.M.

WELL TESTS:

Drawdown 20 ft. after ... hours Pumping 5 G.P.M.
Drawdown ... ft. after ... hours Pumping 13 G.P.M.

USE OF WATER Irrigation Temp. °F. , 19

SOURCE OF INFORMATION GR-2530
DRILLER or DIGGER Steinman Bros., Drilling Co., 15112 S.E. McLoughlin Blvd. Milwaukie, Oregon

ADDITIONAL DATA:

Log X Water Level Measurements Chemical Analysis Aquifer Test

REMARKS:

Dug well (Later filled), water bearing 36
Brown hard pan 14 50
Soft yellow rock, water bearing 35 85
Grey rock, not water bearing 8 93
Decomposed rock & clay, water bearing 9 min. 102
Bottom of well