

STATE ENGINEER
Salem, Oregon

WASH
012075

Well Record

STATE WELL NO. 2/1W-28L
COUNTY Washington
APPLICATION NO. GR-2953

OWNER: R. W. Berg and Ellen Berg


MAILING ADDRESS: Route 1, Box 9A

LOCATION OF WELL: Owner's No.

CITY AND STATE: Sherwood, Oregon

NE 1/4 SW 1/4 Sec. 28 T. 2 N. S, R. 1 E. W., W.M.

Bearing and distance from section or subdivision corner 1650 feet N. and 1680 feet E.

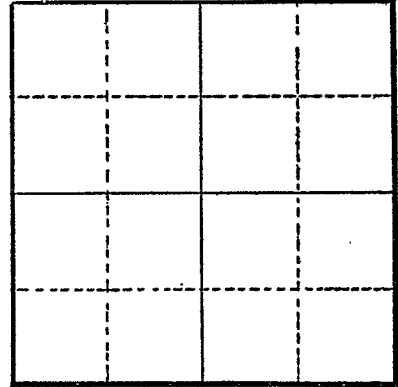

Section

Altitude at well

TYPE OF WELL: Drilled Date Constructed 1955

Depth drilled 80 feet Depth cased

CASING RECORD:

6-inch

FINISH:

AQUIFERS:

Dirt and rock

WATER LEVEL:

55 feet

PUMPING EQUIPMENT: Type Meyers - Jet Pump H.P. 1 1/2
Capacity 21 G.P.M.

WELL TESTS:

Drawdown 15 ft. after hours Pumping 55 - 60 G.P.M.
Drawdown ft. after hours G.P.M.

USE OF WATER Irrigation Temp. °F., 19

SOURCE OF INFORMATION GR-2897

DRILLER or DIGGER

ADDITIONAL DATA:

Log Water Level Measurements Chemical Analysis Aquifer Test

REMARKS:

Dirt 7
Solid Rock 73 80