

STATE ENGINEER  
Salem, Oregon

WASH  
012101

Well Record

STATE WELL NO. 2/1-29A  
COUNTY Washington  
APPLICATION NO. GR-2153

OWNER: Henry & Elma Burck  
MAILING ADDRESS: Rt. 4, Box 27

LOCATION OF WELL: Owner's No. \_\_\_\_\_  
CITY AND STATE: Sherwood, Oregon


NE 1/4 NE 1/4 Sec. 29 T. 2 S., R. 1 W., W.M.

Bearing and distance from section or subdivision corner

Altitude at well

TYPE OF WELL: Dug Date Constructed 9 1950

Depth drilled 8' Depth cased

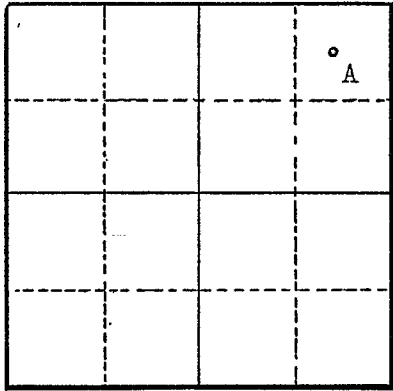

Section 29

CASING RECORD:

FINISH:

AQUIFERS:

WATER LEVEL:

PUMPING EQUIPMENT: Type Fairbanks Morse H.P. 15  
Capacity 144 G.P.M.

WELL TESTS:  
Drawdown ft. after hours G.P.M.  
Drawdown ft. after hours G.P.M.

USE OF WATER Irrigation Temp. °F., 19

SOURCE OF INFORMATION GR-4004

DRILLER or DIGGER

ADDITIONAL DATA:  
Log NA Water Level Measurements Chemical Analysis Aquifer Test

REMARKS: