

STATE ENGINEER  
Salem, Oregon

WASH  
012219

Well Record

STATE WELL NO. 2/1W-35K  
COUNTY WASHINGTON  
APPLICATION NO. GR-2848

OWNER: Ben D. Andrews

MAILING ADDRESS: Rt. 1, Box 390 A.


LOCATION OF WELL: Owner's No.

CITY AND STATE: Sherwood, Oregon

NW 1/4 SE 1/4 Sec. 35 T. 2 N. S, R. 1 E. W.M.

Bearing and distance from section or subdivision

corner 160' E.

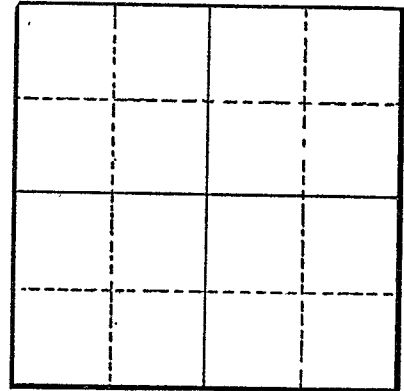

Section

Altitude at well

TYPE OF WELL: drilled Date Constructed 1947

Depth drilled 200 Depth cased 68

CASING RECORD:

6-inch

FINISH:

AQUIFERS:

WATER LEVEL:

67-feet

PUMPING EQUIPMENT: Type Jacuzzi Jet H.P. 5  
Capacity 30 G.P.M.

WELL TESTS:  
Drawdown 12 ft. after hours Pumping 30 G.P.M.  
Drawdown ft. after hours G.P.M.

USE OF WATER irrigation Temp. °F. 19

SOURCE OF INFORMATION GR-2682

DRILLER or DIGGER Steinman Brothers, Portland, Oregon

ADDITIONAL DATA:

Log Water Level Measurements Chemical Analysis Aquifer Test

REMARKS: