

STATE ENGINEER
Salem, Oregon

WASH
012243

Well Record

STATE WELL NO. 2/LW-350
COUNTY Washington
APPLICATION NO. GR-3427

OWNER: Bob L. McEvers


MAILING ADDRESS: Route 1, Box 387 A

LOCATION OF WELL: Owner's No.

CITY AND STATE: Sherwood

SW 1/4 SE 1/4 Sec. 35 T. 2 N. S., R. 1 E. W., W.M.

Bearing and distance from section or subdivision corner 320' E. and 370' N.

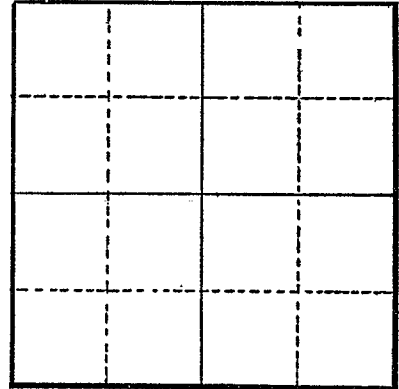

Section

Altitude at well

TYPE OF WELL: drilled Date Constructed 1950

Depth drilled 183' Depth cased 44'9"

CASING RECORD:

6"

FINISH:

AQUIFERS:

WATER LEVEL:

120'

PUMPING EQUIPMENT: Type Jacuzzi Jet H.P. 2

Capacity G.P.M.

WELL TESTS:

Drawdown ft. after hours pumping 35 G.P.M.

Drawdown ft. after hours G.P.M.

USE OF WATER Irrigation Temp. °F., 19

SOURCE OF INFORMATION GR-3171

DRILLER or DIGGER Klundt Bros. 12612 SE Vernie Ave. Milwaukie, Oregon

ADDITIONAL DATA:

Log Water Level Measurements Chemical Analysis Aquifer Test

REMARKS: