

STATE ENGINEER
Salem, Oregon

WASH Well Record
012375

STATE WELL NO. *2561 1160*
APPLICATION NO. *GE 2*

OWNER: *Blarly Brothers*


MAILING ADDRESS:
CITY AND STATE:

Pg 1 of 4

LOCATION OF WELL: Owner's No. _____

N.E. 1/4 S.E. 1/4 Sec. 1 T. 2 N. S. R. 2 E. W.M.

Bearing and distance from section or subdivision corner _____

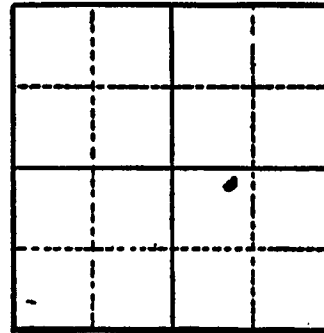

Section _____

Altitude at well *285 ft.*

TYPE OF WELL: *drilled* Date Constructed _____

Depth drilled *588 ft.* Depth cased *57 ft.*

CASING RECORD: *12 inch.*

FINISH:

AQUIFERS: *Ba salt from 368 to 588 ft.*

WATER LEVEL: *112.0 ft. below land surface. 9-29-51*

PUMPING EQUIPMENT: Type *Turbine* H.P. _____
Capacity _____ G.P.M.

WELL TESTS:
Drawdown _____ ft. after _____ hours _____ G.P.M.
Drawdown _____ ft. after _____ hours _____ G.P.M.

USE OF WATER *Irrigation* Temp. _____ °F. _____, 19 _____

SOURCE OF INFORMATION *U.S.G.S.*

DRILLER or DIGGER _____

ADDITIONAL DATA:
Log Water Level Measurements _____ Chemical Analysis _____ Aquifer Test _____

REMARKS: *Used for irrigating 50 acres of pasture; see table 2 for log; pumped at rate of 588 gpm. with 45 ft. of drawdown for 4 hours during aquifer test by U.S.G.S.*

Mari 12375 Pg 3 of 4

NO. VES. STATION
Date

County

Age of

Water Level Record

OWNER: Berky, Brass

OWNER'S NO.

Description of measuring point: Owners air line and gage

Date	Water Level Foot (above/ below) Land Surface	Remarks	Date	Water Level Foot (above/ below) Land Surface	Remarks
9-20-51	112	11-30-52			
4-22-59	114	11-3			
1-11-61	112	11-17			

REMARKS

STATE ENGINEER
Salem, Oregon

WASH
012375

Well Record

STATE WELL NO. 2/24-1J
COUNTY WASHINGTON
APPLICATION NO. GR-2954

OWNER: Orville L. & Hubert F. Hierly


MAILING ADDRESS: Rt. 1, Pg 4 of 4

LOCATION OF WELL: Owner's No.

CITY AND STATE: Beaverton, Oregon

NE 1/4 SE 1/4 Sec. 1 T. 2 N. S. R. 2 W., W.M.

Bearing and distance from section or subdivision corner 2840' S. and 1000' W.

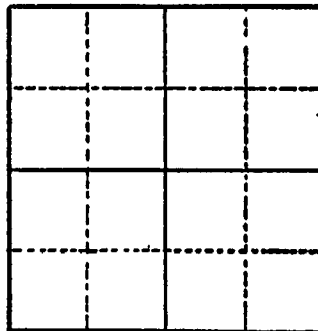

Altitude at well

TYPE OF WELL: drilled Date Constructed 1950

Depth drilled 590 Depth cased 590

Section

CASING RECORD:

12-inch
12-inch
8-inch

FINISH:

AQUIFERS:

WATER LEVEL:

100-feet

PUMPING EQUIPMENT: Type Layne - Bowler Turbine H.P. 40

Capacity 500 G.P.M.

WELL TESTS:

Drawdown ft. after hours G.P.M.

Drawdown ft. after hours G.P.M.

USE OF WATER Irrigation Temp. °F., 19

SOURCE OF INFORMATION GR-2772

DRILLER or DIGGER A. M. Janssen, Reedville, Oregon

ADDITIONAL DATA:

Log Water Level Measurements Chemical Analysis Aquifer Test

REMARKS: