

STATE ENGINEER
Salem, Oregon

WASH
012414 Well Record

STATE WELL NO. 23/2W 280
COUNTY Washington
APPLICATION NO.

OWNER: Fred Grener


MAILING ADDRESS:

LOCATION OF WELL: Owner's No.

CITY AND STATE:

1/4 1/4 Sec. T. N. S, R. E. W., W.M.

Bearing and distance from section or subdivision corner

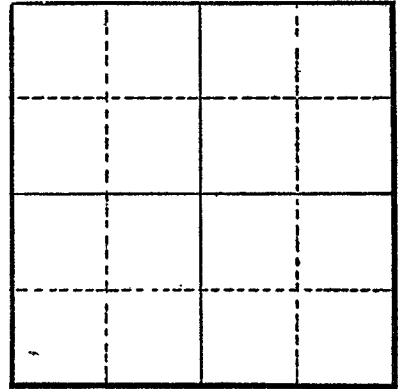

Section

Altitude at well 175 ft.

TYPE OF WELL: drilled Date Constructed

Depth drilled 400 ft. Depth cased 250 ft.

CASING RECORD: 10-6 inch.

FINISH:

AQUIFERS: Basalt.

WATER LEVEL: F

PUMPING EQUIPMENT: Type Centrifugal H.P.

Capacity G.P.M.

WELL TESTS:

Drawdown ft. after hours G.P.M.

Drawdown ft. after hours G.P.M.

USE OF WATER domestic & stock Temp. °F. 19

SOURCE OF INFORMATION U.S.G.S.

DRILLER or DIGGER

ADDITIONAL DATA:

Log Water Level Measurements Chemical Analysis Aquifer Test

REMARKS: Plugged at 250 ft.