

STATE ENGINEER  
Salem, Oregon

WASH  
012415 Well Record


STATE WELL NO. 2/ZW-3K  
COUNTY Washington  
APPLICATION NO. GR-3872

OWNER: Virgil Bish MAILING ADDRESS: Route 2, Box 212

LOCATION OF WELL: Owner's No. CITY AND STATE: Hillsboro, Oregon

NW 1/4 SE 1/4 Sec. 3 T. 2 S., R. 2 W., W.M.

Bearing and distance from section or subdivision corner 1830' N. & 60' E. of S 1/4 Cor. Sec. 3

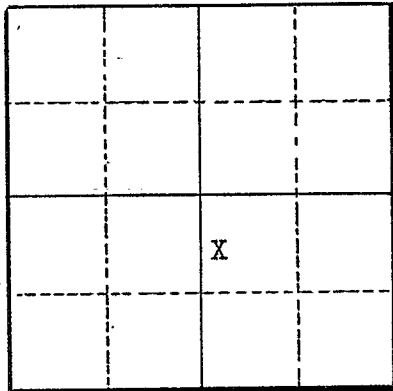

Section 3

Altitude at well

TYPE OF WELL: Drilled Date Constructed 1922

Depth drilled 700 feet Depth cased

CASING RECORD:

FINISH:

AQUIFERS:

WATER LEVEL:

11.3 feet below surface

PUMPING EQUIPMENT: Type Myers Ejecto H.P. 1  
Capacity 33 G.P.M.

WELL TESTS:

Drawdown ft. after hours G.P.M.  
Drawdown ft. after hours G.P.M.

USE OF WATER Irrigation Temp. °F., 19  
SOURCE OF INFORMATION Well Registration Statement Cert. # GR-3522

DRILLER or DIGGER

ADDITIONAL DATA:

Log Water Level Measurements Chemical Analysis Aquifer Test

REMARKS: