

STATE ENGINEER
Salem, Oregon

WASH
012444

Well Record

STATE WELL NO. 272W (P.L.)
COUNTY Washington
APPLICATION NO.

OWNER: J. Spiering


MAILING
ADDRESS:

LOCATION OF WELL: Owner's No.

CITY AND
STATE:

1/4 1/4 Sec. T. N. E.
S., R. W., W.M.

Bearing and distance from section or subdivision
corner

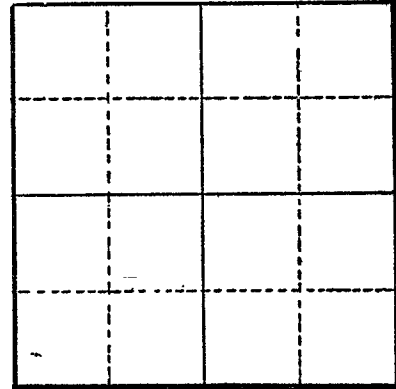

Altitude at well 180 ft.

TYPE OF WELL: drilled Date Constructed

Depth drilled 437 ft. Depth cased 218 ft.

Section

CASING RECORD: 6 inch.

FINISH:

AQUIFERS: Basalt from 218 to 437 ft.

WATER LEVEL: F

PUMPING EQUIPMENT: Type Jet H.P.
Capacity G.P.M.

WELL TESTS:
Drawdown ft. after hours G.P.M.
Drawdown ft. after hours G.P.M.

USE OF WATER domestic & stock Temp. °F. 19

SOURCE OF INFORMATION U.S.G.S.

DRILLER or DIGGER

ADDITIONAL DATA:

Log Water Level Measurements Chemical Analysis Aquifer Test

REMARKS: Reported 218 ft. of clay above aquifer;
well flowing 1/2 g.p.m.