

STATE ENGINEER
Salem, Oregon

WASH Well Record
012497


STATE WELL NO. *25/2W 8E(1)*
COUNTY *Washington*
APPLICATION NO. _____

OWNER: *Robert Hiatt* MAILING ADDRESS: _____

LOCATION OF WELL: Owner's No. _____ CITY AND STATE: _____

..... 1/4 1/4 Sec. T. N. E. S., R. W., W.M.

Bearing and distance from section or subdivision corner _____

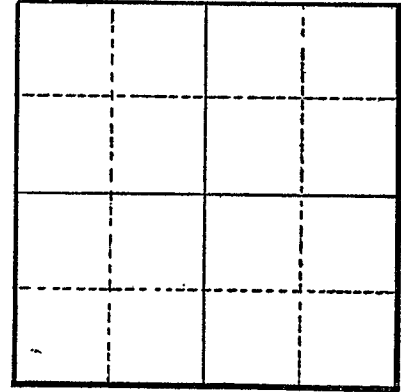

Section _____

Altitude at well *180 ft.*

TYPE OF WELL: *drilled* Date Constructed *1946*

Depth drilled *215 ft.* Depth cased *195 ft.*

CASING RECORD: *6 inch.*

FINISH: _____

AQUIFERS: *Basalt from 195 to 215 ft.*

WATER LEVEL: *18 ft. below land surface.*

PUMPING EQUIPMENT: Type *Jet 6" Sub.* H.P. *7 1/2*
Capacity _____ G.P.M.

WELL TESTS:
Drawdown _____ ft. after _____ hours _____ G.P.M.
Drawdown _____ ft. after _____ hours _____ G.P.M.

USE OF WATER *domestic* Temp. _____ °F. _____, 19____

SOURCE OF INFORMATION *U.S.G.S.*

DRILLER or DIGGER _____

ADDITIONAL DATA:

Log *no* Water Level Measurements _____ Chemical Analysis _____ Aquifer Test _____

REMARKS: *Water reported to contain iron.*