

STATE ENGINEER
Salem, Oregon

WASH
012570

Well Record

STATE WELL NO. 2/2W-10P
COUNTY _____
APPLICATION NO. _____

OWNER: Schalls Methodist Church MAILING ADDRESS: _____

LOCATION OF WELL: Owner's No. _____ CITY AND STATE: _____

_____ 1/4 _____ 1/4 Sec. _____ T. _____ N. _____ E.
S., R. _____ W., W.M.


Bearing and distance from section or subdivision
corner _____

Altitude at well 135 ft.

TYPE OF WELL: drilled Date Constructed _____

Depth drilled 553 ft. Depth cased 513 ft.

CASING RECORD: 4 inch.

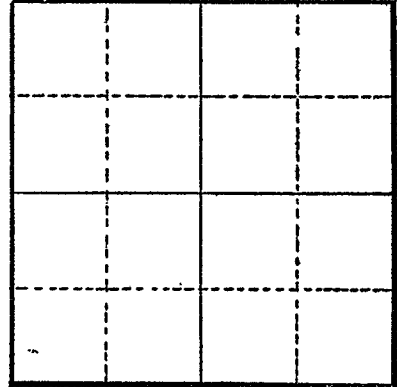

Section _____

FINISH: _____

AQUIFERS: Basalt from 152 to 167 ft.

WATER LEVEL: F

PUMPING EQUIPMENT: Type Jet H.P. _____
Capacity _____ G.P.M.

WELL TESTS:
Drawdown _____ ft. after _____ hours _____ G.P.M.
Drawdown _____ ft. after _____ hours _____ G.P.M.

USE OF WATER public supply Temp. _____ °F. _____, 19 _____

SOURCE OF INFORMATION U.S.G.S.

DRILLER or DIGGER _____

ADDITIONAL DATA:
Log _____ Water Level Measurements _____ Chemical Analysis _____ Aquifer Test _____

REMARKS: Reported materials, 512 ft. of clay and sand,
41 ft. of rock; flows about 2 g.p.m.