

STATE ENGINEER **WASH**
Salem, Oregon **012594**

Well Record

STATE WELL NO. **212W-12C(1)**
COUNTY **Wash.**
APPLICATION NO. **GR-379**


OWNER: **Julius Wedeking**

MAILING ADDRESS: **Rt. 1 Box 878**
CITY AND STATE: **Beaverton, Ore.**

LOCATION OF WELL: Owner's No. _____

NE 1/4 NW 1/4 Sec. 12 T. 2 S., R. 2 W., W.M.

Bearing and distance from section or subdivision corner **410 ft. E & 150 ft. S. of N.E. corner of Thomas Humphrey D.L.C.**

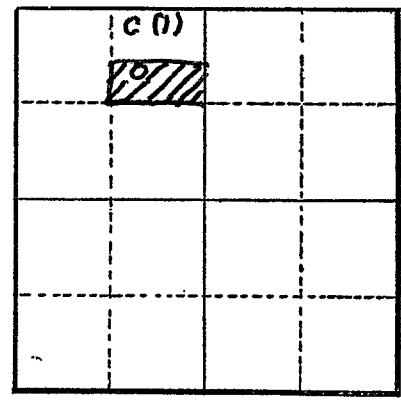

Altitude at well **175**

TYPE OF WELL: **drilled** Date Constructed **June 16, '55**

Depth drilled **315** Depth cased **124**

Section **12**

CASING RECORD:

8 inch

FINISH:

AQUIFERS:

WATER LEVEL:

25

PUMPING EQUIPMENT: Type **Jacuzzi submersible** H.P. **7.5**
Capacity **80** G.P.M.

WELL TESTS:

Drawdown _____ ft. after _____ hours _____ G.P.M.
Drawdown _____ ft. after _____ hours _____ G.P.M.

USE OF WATER **irrigation-15** Temp. _____ °F. _____, 19____

SOURCE OF INFORMATION **GR-379**

DRILLER or DIGGER **A. J. Gaunt; Aloha, Ore.**

ADDITIONAL DATA:

Log _____ Water Level Measurements _____ Chemical Analysis _____ Aquifer Test _____

REMARKS:

↓
Dirt - - - - 0 to 124
Rock - - - - 124 to 315