

STATE ENGINEER  
Salem, Oregon

WASH

Well Record

012679


STATE WELL NO. 2/2W - 16N(1)  
COUNTY WASHINGTON  
APPLICATION NO. GR-2017

OWNER: Mountainside Cemetery Association MAILING ADDRESS: Rt. 1, Box 95

LOCATION OF WELL: Owner's No. CITY AND STATE: Newberg, Oregon

NE 1/4 SW 1/4 SW 1/4 Sec. 16 T. 2 N. S. R. 2 W., W.M.

Bearing and distance from section or subdivision corner 1125' N. and 800' E.

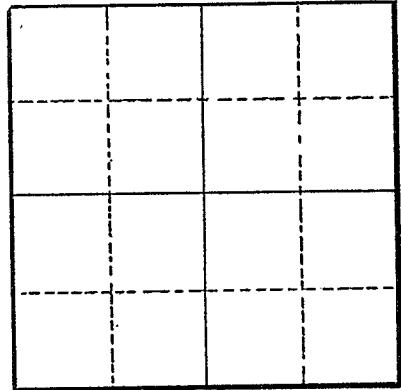

Section

Altitude at well

TYPE OF WELL: Drilled Date Constructed 1953

Depth drilled 231 Depth cased 175 - 53

CASING RECORD:

4-inch  
6-inch

FINISH:

AQUIFERS:

Top soil, sediments and rock

WATER LEVEL:

27-feet

PUMPING EQUIPMENT: Type Pacific submersible 14 stages H.P. 5  
Capacity 36 G.P.M.

WELL TESTS:

Drawdown 155 ft. after hours Pumping 39 G.P.M.  
Drawdown ft. after hours G.P.M.

USE OF WATER Irrigation Temp. °F., 19

SOURCE OF INFORMATION GR-1944  
DRILLER or DIGGER A. J. Gaunt, 3250 S. W. 185th., Aloha, Oregon

ADDITIONAL DATA:

Log X Water Level Measurements Chemical Analysis Aquifer Test

REMARKS:

Top soil 0  
Sediments 48  
Rock 48 231