

STATE ENGINEER
Salem, Oregon

WASH
12733

Well Record

B 1 of 3
STATE WELL NO. 2/2W-17F
COUNTY Washington
APPLICATION NO GR-3134

OWNER: Ruth M. Newton and Charles M. Newton MAILING ADDRESS: Route 4, Box 251

LOCATION OF WELL: Owner's No. CITY AND STATE: Hillsboro, Oregon

W¹/₂ SE ¹/₄ NW ¹/₄ Sec. 17 T. 2 S. R. 2 W., W.M.

Bearing and distance from section or subdivision
corner 270' W. and 155' N.

Altitude at well

TYPE OF WELL: Drilled Date Constructed 1949

Depth drilled 272' Depth cased 150'

Section

CASING RECORD:

6"

FINISH:

AQUIFERS:

soil, clay, sand, rock, gray basalt,

WATER LEVEL:

3'

PUMPING EQUIPMENT: Type Meyers Ejecto (shallow well)

H.P. 1

Capacity 15 G.P.M.

WELL TESTS:

Drawdown 15 ft. after hours pumping 15 G.P.M.

Drawdown 15 ft. after hours pumping 15 G.P.M.

USE OF WATER Irrigation Temp. °F. 19

SOURCE OF INFORMATION Gr-2939

DRILLER or DIGGER Glenn and Orval Harty 309 W. Jackson, Hillsboro, Oregon

ADDITIONAL DATA:

Log ☒ Water Level Measurements ☐ Chemical Analysis ☐ Aquifer Test ☐

REMARKS:

STATE ENGINEER
Salem, Oregon

WASH
12733

Well Record

STATE WELL NO. 272W 1760
COUNTY Washington
APPLICATION NO. Pg 2 of 3

OWNER: Charles Newton

MAILING
ADDRESS:

LOCATION OF WELL: Owner's No. _____

CITY AND
STATE: _____

_____ 1/4 _____ 1/4 Sec. _____ T. _____ N. _____ E.
S., R. _____ W., W.M.


Bearing and distance from section or subdivision
corner _____

Altitude at well 165 ft.

TYPE OF WELL: drilled Date Constructed _____

Depth drilled 272 ft. Depth cased 140 ft.

CASING RECORD: 6 inch.

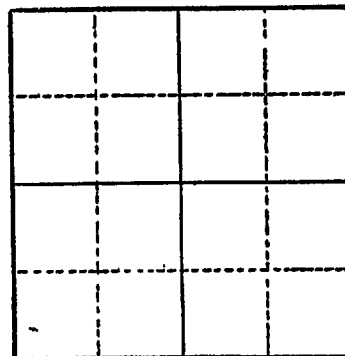

Section _____

FINISH:

AQUIFERS: Basalt from 140 to 272 ft.

WATER LEVEL: F

PUMPING EQUIPMENT: Type Centrifugal H.P. _____
Capacity _____ G.P.M.

WELL TESTS:

Drawdown _____ ft. after _____ hours _____ G.P.M.
Drawdown _____ ft. after _____ hours _____ G.P.M.

USE OF WATER domestic Temp. _____ °F. _____, 19 _____

SOURCE OF INFORMATION U.S.G.S.

DRILLER or DIGGER _____

ADDITIONAL DATA:

Log _____ Water Level Measurements _____ Chemical Analysis _____ Aquifer Test _____

REMARKS: Water said to flow 3 gpm. from December to July.

Wash
12733

Pg 3 of 3

Pg 3 of 3

Driller: Glenn and Orval Harty Date Drilled 1949

[illegible]