

STATE ENGINEER
Salem, Oregon

WASH
013321

Well Record

STATE WELL NO. 258W 1ACD
COUNTY Washington
APPLICATION NO. _____

OWNER: Harold Haase


MAILING ADDRESS: _____

LOCATION OF WELL: Owner's No. _____

CITY AND STATE: _____

_____ 1/4 _____ 1/4 Sec. _____ T. _____ N. _____ E.
S., R. _____ W., W.M.

Bearing and distance from section or subdivision corner _____

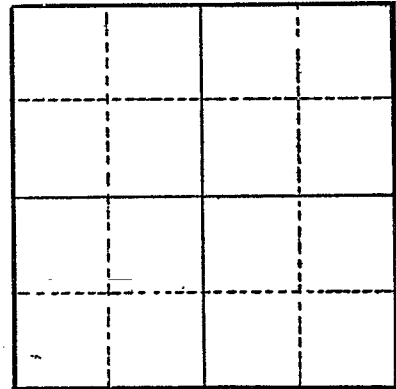

Section _____

Altitude at well 180 ft.

TYPE OF WELL: drilled Date Constructed _____

Depth drilled 405 ft. Depth cased 289 ft.

CASING RECORD: 6 inch.

FINISH: _____

AQUIFERS: Basalt from 286 to 405 ft.

WATER LEVEL: 1.68 ft. below land surface.

PUMPING EQUIPMENT: Type Jet _____ H.P. _____
Capacity _____ G.P.M.

WELL TESTS:
Drawdown _____ ft. after _____ hours _____ G.P.M.
Drawdown _____ ft. after _____ hours _____ G.P.M.

USE OF WATER domestic Temp. _____ °F. _____, 19 _____

SOURCE OF INFORMATION U.S.G.S.

DRILLER or DIGGER _____

ADDITIONAL DATA:

Log Water Level Measurements _____ Chemical Analysis _____ Aquifer Test _____

REMARKS: drawdown reported to be 13 ft. when pumped at 45 gpm. for 5 hours; reportedly flowed 10 gpm. in 1948; see page Table 2 for log.

