

STATE OF OREGON
WATER WELL REPORT
 (as required by ORS 537.785)

RECEIVED

NOV - 7 1985

PLEASE TYPE or PRINT IN INK

WATER RESOURCES DEPT

WASH
 013591

35/W-2cc
 Deep.

(for official use only)

(1) OWNER:

SALEM, OREGON

Name Larry and Debbie Floyd
 Address 25750 S. W. Garden Acres Road
 City Sherwood 97140 State Oregon

(2) TYPE OF WORK (check):

New Well Deepening Reconditioning Abandon
 If abandonment, describe material and procedure in Item 12.

(3) TYPE OF WELL:

Rotary Air Driven
 Rotary Mud Dug
 Cased Bored

(4) PROPOSED USE (check):

Domestic Industrial Municipal
 Thermal Withdrawal ReInjection
 Irrigation Other:
 Piezometric Grounding Test

(5) CASING INSTALLED:

Steel Plastic
 Threaded Welded
 6" Diam. from 0 ft. to 59 ft. Gauge .250
 " Diam. from ft. to ft. Gauge

LINER INSTALLED:

Steel Plastic
 Threaded Welded
 " Diam. from ft. to ft. Gauge

(6) PERFORATIONS:

Perforated? Yes No
 Size of perforations in. by in.
 perforations from ft. to ft.
 perforations from ft. to ft.
 perforations from ft. to ft.

(7) SCREENS:

Well screen installed? Yes No
 Manufacturer's Name
 Type Model No.
 Diam. Slot Size Set from ft. to ft.
 Diam. Slot Size Set from ft. to ft.

(8) WELL TESTS:

Drawdown is amount water level is lowered below static level
 Was a pump test made? Yes No If yes, by whom?
 d: gal./min. with ft. drawdown after hrs.
 Air test gal./min. with drill stem at ft. hrs.
 Bailer test 35 gal./min. with 62 ft. drawdown after one hrs.
 Artesian flow g.p.m.
 Temperature of water 53° Depth artesian flow encountered ft.

(9) CONSTRUCTION:

Special standards: Yes No
 Well seal—Material used See Item #12
 Well sealed from land surface to ft.
 Diameter of well bore to bottom of seal in.
 Diameter of well bore below seal in.
 Amount of sealing material sacks pounds

(10) LOCATION OF WELL by legal description:

County Washington SW $\frac{1}{4}$ SW $\frac{1}{4}$ of Section 2 of
 Township 3-South Range 1-West WM.
 (Township is North or South) (Range is East or West)

Tax Lot _____ Lot _____ Block _____ Subdivision _____

MAILING ADDRESS OF WELL (or nearest address) 25750 S. W. Garden Acres Road, Sherwood, Ora. 97140

Drillers Well #27-52/23-85 Deepening

(11) WATER LEVEL OF COMPLETED WELL:

Depth at which water was first found 85 ft.
 Static level 64 ft. below land surface. Date 10-5-85
 Artesian pressure lbs. per square inch. Date

(12) WELL LOG:

Diameter of well below casing 6-inch
 Depth drilled 121 ft. Depth of completed well 121 ft.
 Formation: Describe color, texture, grain size and structure of materials; and show thickness and nature of each stratum and aquifer penetrated, with at least one entry for each change of formation. Report each change in position of Static Water Level and indicate principal water-bearing strata.

MATERIAL	From	To	SWL
This well was drilled in 1952 for Richard D. Vandemarr by Steinman Bros. Drilling Co. On August 9, 1952, Static Water Level was 11 feet; the well was 85 feet deep, and the yield by bailer test produced over 35 g.p.m. Clay; brown		0	3
Cemented gravel and large boulders	3	15	
Clay; yellow and red	15	50	
Basalt; brown	50	82	
Basalt; gray	82	97	
Basalt; brown	97	121	64

Date work started October 4, 1985 completed October 5, 1985

Date well drilling machine moved off of well October 7, 1985

(unbonded) Water Well Constructor Certification (if applicable):

This well was constructed under my direct supervision. Materials used and information reported above are true to my best knowledge and belief.

[Signed] _____ Date _____, 19 _____

(bonded) Water Well Constructor Certification:


Bond 7560982 Issued by: Great American
 (number) (Surety Company Name)

On behalf of Ronald F. McConnell, dba Steinman Bros. Drilling Co., Oregon License #1
 (type of print name of Water Well Constructor)

This well was drilled under my jurisdiction and this report is true to the best of my knowledge and belief.

(Signed) Ronald F. McConnell
 Ronald F. McConnell (Well Constructor)

(Dated) November 4, 1985

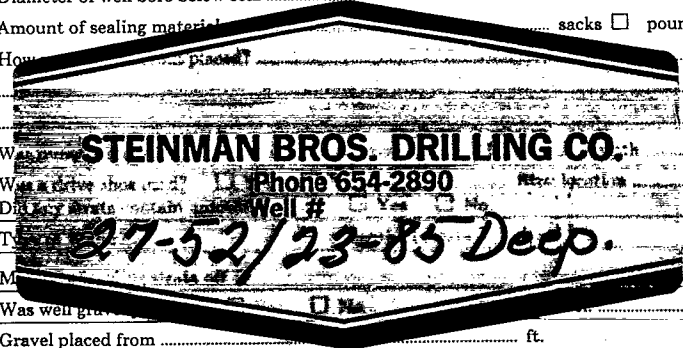

NOTICE TO WATER WELL CONSTRUCTOR
 The original and first copy of this report are to be filed with the

WATER RESOURCES DEPARTMENT,
 SALEM, OREGON 97310
 within 30 days from the date of well completion.

SP*46866-690