

STATE ENGINEER
Salem, Oregon

Well Record **WASH** STATE WELL NO. 3/1W-2D
013649 COUNTY Washington
GR- 1725 APPLICATION NO. GR- 1783

OWNER: Lee H. & Marion B. Thompson


MAILING ADDRESS: Rt. 2, Box 108A

LOCATION OF WELL: Owner's No.

CITY AND STATE: Sherwood, Oregon

NW 1/4 NW 1/4 Sec. 2 T. 3 S, R. 1 W., W.M.

Bearing and distance from section or subdivision corner 465' E. & 90' S. from NW cor. Sec. 2

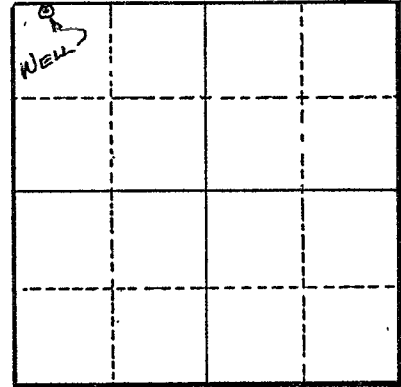

Altitude at well 240'

TYPE OF WELL: Drilled Date Constructed 1950

Depth drilled 247' Depth cased 50'

Section 2

CASING RECORD:
6"

FINISH:

AQUIFERS:

WATER LEVEL:
60'

PUMPING EQUIPMENT: Type Sumo submersible H.P. 3
Capacity 55 G.P.M.

WELL TESTS:
Drawdown ft. after hours G.P.M.
Drawdown ft. after hours G.P.M.

USE OF WATER Irrigation Temp. °F., 19

SOURCE OF INFORMATION GR Record

DRILLER or DIGGER

ADDITIONAL DATA:
Log Water Level Measurements Chemical Analysis Aquifer Test

REMARKS:

Log: Rock, rotten 0 to 50 ft.
Rock 50 to 247 ft.

Irrigation of 11 acres.