

STATE ENGINEER
Salem, Oregon

WASH
13832

Well Record

STATE WELL NO. 1N/2W 6M(1)
COUNTY Washington
APPLICATION NO. _____

OWNER: John A. Van Domelen
MAILING ADDRESS: _____

LOCATION OF WELL: Owner's No. _____
CITY AND STATE: _____


_____ 1/4 _____ 1/4 Sec. _____ T. _____ N. _____ E.
S., R. _____ W., W.M.

Bearing and distance from section or subdivision
corner _____

Altitude at well 180

TYPE OF WELL: drilled Date Constructed _____

Depth drilled 452 Depth cased 327

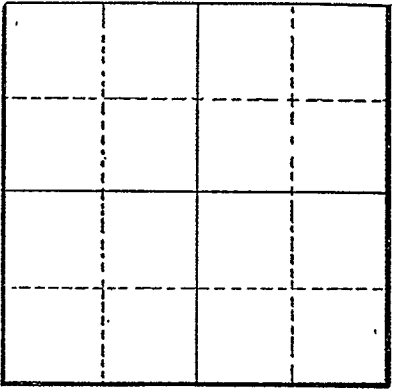

Section 6

CASING RECORD: 6 inch.

FINISH: _____

AQUIFERS: do.

WATER LEVEL: fa.

PUMPING EQUIPMENT: Type jet H.P. _____
Capacity _____ G.P.M.

WELL TESTS:
Drawdown _____ ft. after _____ hours _____ G.P.M.
Drawdown _____ ft. after _____ hours _____ G.P.M.

USE OF WATER domestic & stock Temp. _____ °F. _____, 19

SOURCE OF INFORMATION USGS

DRILLER or DIGGER _____

ADDITIONAL DATA:
Log _____ Water Level Measurements _____ Chemical Analysis _____ Aquifer Test _____

REMARKS: Flows about 4 gpm., main flow from 451 to 452 ft.