

STATE ENGINEER  
Salem, Oregon

Wash  
1821

# Well Record

GR- 1706


STATE WELL NO. 2/1W-32F(2)  
COUNTY Washington  
APPLICATION NO. GR- 1160

OWNER: H.G. Albert, Sherwood city recorder Mailing ADDRESS: \_\_\_\_\_

LOCATION OF WELL: Owner's No. #2 CITY AND STATE: Sherwood, Oregon

SE 1/4 NW 1/4 Sec. 32 T. 2 S, R. 1 W., W.M.

Bearing and distance from section or subdivision corner 1680' S. & 1610' E. from NW cor. Sec. 32

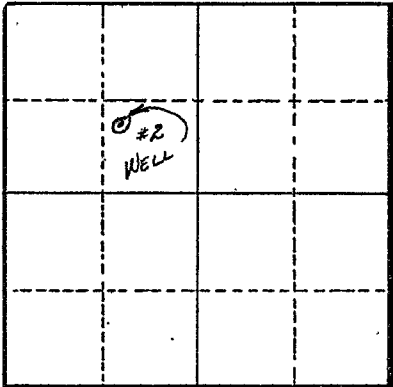

Section 32

Altitude at well 193'

TYPE OF WELL: Drilled Date Constructed 1922

Depth drilled 180' Depth cased 180'

CASING RECORD:  
6"

FINISH:

AQUIFERS:

WATER LEVEL:  
32 to 40 ft.

PUMPING EQUIPMENT: Type Rotary with booster H.P. 10  
Capacity 220 G.P.M.

WELL TESTS:  
Drawdown 0 ft. after \_\_\_\_\_ hours 220 G.P.M.  
Drawdown \_\_\_\_\_ ft. after \_\_\_\_\_ hours \_\_\_\_\_ G.P.M.

USE OF WATER Mun., Man. & Ind. Temp. °F. \_\_\_\_\_, 19

SOURCE OF INFORMATION GR Record

DRILLER or DIGGER Jack Morback

ADDITIONAL DATA:  
Log N.A. Water Level Measurements \_\_\_\_\_ Chemical Analysis \_\_\_\_\_ Aquifer Test \_\_\_\_\_

REMARKS:

2/1w-32 F 2

**RECEIVED**  
JUN 2 1965  
STATE ENGINEER  
SALEM OREGON

OREGON STATE BOARD OF HEALTH

Mineral Content of Water

Name of Water Supply Sherwood

Source Well #2

Sampling Point \_\_\_\_\_

Collected By F.G. Katzel Date 4/6/65

Analysis By A.W. Hose Date 5-28-65

Laboratory Number 945

	<u>Mg/L</u>		<u>Mg/L</u>
Color _____	1	Conductance (mc mho/cm) _____	205
Turbidity _____	144	Chlorides _____	3.3
Solids, Total _____	276	Sodium _____	10.0
Solids, Volatile _____	78	Potassium _____	2.0
Carbon Dioxide _____	50	Fluoride _____	0.37
pH _____	6.6	Phosphates _____	0.06
Alkalinity, Total as CaCO <sub>3</sub> _____	100	Sulfates _____	0.5
Hardness as CaCO <sub>3</sub> _____	86.9	Silicon _____	52
Calcium _____	19.1	Aluminum _____	<0.01
Magnesium _____	9.5	Nitrogen, Ammonia _____	0.37
Iron _____	16.3	Nitrogen, Nitrite _____	<0.01
Manganese _____	<0.05	Nitrogen, Nitrate _____	0.15
Arsenic _____	<0.005		

REMARKS \_\_\_\_\_  
\_\_\_\_\_  
\_\_\_\_\_