

STATE ENGINEER  
Salem, Oregon

*Well*  
*1823*

# OBSERVATION WELL Well Record

GR- 1708


STATE WELL NO. 2/1W-32F(3)  
COUNTY Washington  
APPLICATION NO. GR- 1162

OWNER: H.G. Albert, Sherwood city recorder MAILING ADDRESS: .....

LOCATION OF WELL: Owner's No. #3 CITY AND STATE: Sherwood, Oregon

SE 1/4 NW 1/4 Sec. 32 T. 2 S., R. 1 W., W.M.

Bearing and distance from section or subdivision corner 750' N. & 600' W. from Center of Sec. 32.

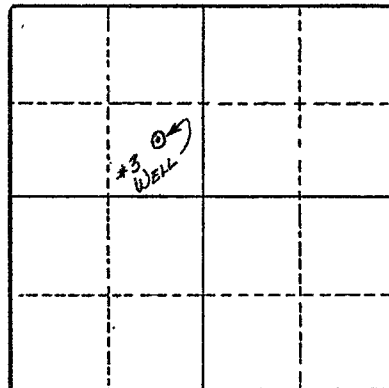

Section 32

Altitude at well 190'

TYPE OF WELL: Drilled Date Constructed 1946

Depth drilled 339' Depth cased 122'

### CASING RECORD:

16" from 0 to 36'  
12" from 35' to 122'

### FINISH:

*BASALT FROM 137' TO 339'*

### AQUIFERS:

### WATER LEVEL:

26'

PUMPING EQUIPMENT: Type Rotary (TURBINE) H.P. 60  
Capacity 510 G.P.M.

### WELL TESTS:

Drawdown 42 ft. after ..... hours 510 G.P.M.  
Drawdown ..... ft. after ..... hours ..... G.P.M.

USE OF WATER Mun., Man. & Ind. Temp. ..... °F., 19

SOURCE OF INFORMATION GR Record

DRILLER or DIGGER .....

### ADDITIONAL DATA:

Log X Water Level Measurements ..... Chemical Analysis ..... Aquifer Test .....

### REMARKS:

Well #3

2/LW-32 F (3)  
Washington

GR - 1162  
Cert. GR - 1708

LOG OF WELL

DRILLED FOR THE CITY OF SHERWOOD, SHERWOOD, OREGON.

BY

A. M. JANNSEN DRILLING CO., 319 FITTOCK BLOCK,  
PORTLAND 5, ORE.

Work started 6-10-46 - Completed 7-17-46

Formation:

From	to	Formation
0'	20'	Clay
20'	38'	Quick sand and blue clay
38'	137'	Sand rock
137'	175'	Lava Rock
175'	182'	Rock
182'	206'	Cemented gravel
206'	254'	Lava Rock
254'	269'	Cemented gravel
269'	273'	Lava Rock
273'	296'	Cemented gravel
296'	339'	Broken Rock

Pipe: 38" of 16"  
77" " 12"

Static Water Level 26'

340 GPM DD to 33'  
460 " DD to 33'  
510 " DD to 42'

