

STATE ENGINEER
Salem, Oregon

Well Record

STATE WELL NO. 3/2W-1N0
COUNTY Washington
APPLICATION NO. GR-662

OWNER: Charles H. & Francis V. Barrett MAILING ADDRESS: Rt 1, Box 107

LOCATION OF WELL: Owner's No. 1 CITY AND STATE: Sherwood, Oregon


SW $\frac{1}{4}$ SW $\frac{1}{4}$ Sec. 1 T. 3 S., R. 2 W., W.M.

Bearing and distance from section or subdivision corner 935 feet North and 120 feet East from SW corner of section 1.

Altitude at well 375 feet Interpolated

TYPE OF WELL: Drilled Date Constructed Aug 12, 1946

Depth drilled 290 ft. Depth cased 58 ft.

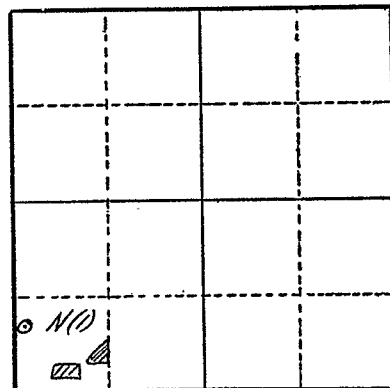

Section 1

CASING RECORD:

6 inch

FINISH:

AQUIFERS:

WATER LEVEL:

190 feet

PUMPING EQUIPMENT: Type Flint & Walling H.P. 3
Capacity 15 G.P.M.

WELL TESTS:

Drawdown ft. after hours G.P.M.
Drawdown ft. after hours G.P.M.

USE OF WATER irrigation - 4 Ac. Temp. °F., 19....

SOURCE OF INFORMATION GR-662

DRILLER or DIGGER Steinman Bros., Portland, Ore.

ADDITIONAL DATA:

Log X Water Level Measurements Chemical Analysis Aquifer Test

REMARKS:

State Well No. 3/24-1N(1)
County Washington
Application No. CR-662

Owner: Charles H. & Francis V. Barrett Owner's No. 1

Driller: _____ Date Drilled Aug. 10, 1946[illegible]