

STATE ENGINEER
Salem, Oregon

WASH 3448 OBSERVATION WELL
Well Record

STATE WELL NO. 3/W-37.K(1)
COUNTY Washington Co.
APPLICATION NO. GR 168


CHARLES KENNERLY

OWNER: Rolph E. Reynolds MAILING ADDRESS: Rt 3, Box 59

LOCATION OF WELL: Owner's No. 1 CITY AND STATE: Sherwood, Ore

NW 1/4 SE 1/4 Sec. 31 T. 2 S., R. 1 W., W.M.

Bearing and distance from section or subdivision corner 450 feet south and 300 feet east from center of section 31.

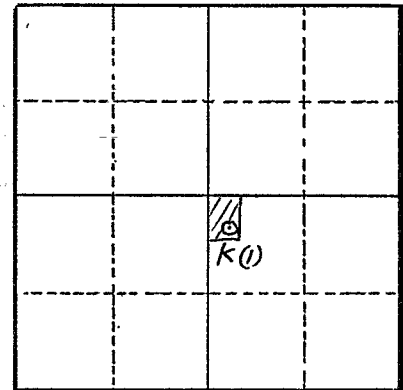

Section 31

Altitude at well 180 feet Interpolated

TYPE OF WELL: Drilled Date Constructed 9/12/52

Depth drilled 215 Depth cased 119

CASING RECORD:

6 — inch casing set from 0 to 119 feet.

FINISH:

None

AQUIFERS:

Unknown - shale?

WATER LEVEL:

30 feet below land surface. 9/25/52

PUMPING EQUIPMENT: Type Peerless Deep well Turbine 3 phase H.P. 7 1/2
Capacity 100 G.P.M.

WELL TESTS:

Drawdown 35 ft. after _____ hours pumping 100 G.P.M.

Drawdown _____ ft. after _____ hours _____ G.P.M.

USE OF WATER Irrigation Temp. _____ °F., 19 _____

SOURCE OF INFORMATION Registration Statement GR-168

DRILLER or DIGGER - John W. Beck - Canby, Oregon

ADDITIONAL DATA:

Log Water Level Measurements _____ Chemical Analysis _____ Aquifer Test _____

REMARKS:

STATE ENGINEER
Salem, Oregon

WASH
3448

State Well No. 2/W-31K(1)

County Washington

Application No. GR-168

Well Log

Owner: Ralph E. Reynolds Owner's No. 1

Driller: John W. Beck Date Drilled 9/12/52

CHARACTER OF MATERIAL	(Feet below land surface)		Thickness (feet)
	From	To	
silt, brown	0	68	68
silt, blue	68	88	20
clay, blue	88	105	13
shale, brown, broken	105	124	19
shale, dark very hard	124	131	7
shale, brown (solid)	131	143	12
shale, blue broken	143	154	11
shale, dark solid	154	180	26
shale, brown (chocolate)	180	215	35
water from broken shale (and crevace at 214 feet.			