

STATE ENGINEER
Salem, Oregon

WASH
4/14/74


Well Record

STATE WELL NO. 1N/1W-21E
COUNTY Washington
APPLICATION NO. GR-3640

OWNER: Elmer Stoller
MAILING ADDRESS: 14025 N.W. Laidlow Rd.
CITY AND STATE: Portland, Oregon

LOCATION OF WELL: Owner's No. _____
SW 1/4 NW 1/4 Sec. 21 T. 1 N. 1 E. S. R. 1 W., W.M.

Bearing and distance from section or subdivision
corner 2565 ft. 331° 30' to NW Cor. 21

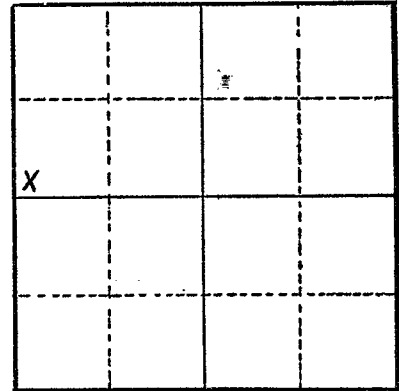

Section 21

Altitude at well _____

TYPE OF WELL: Drilled Date Constructed Jan., 1955

Depth drilled 338 ft. Depth cased 261 feet

CASING RECORD:

8 inch casing set to 261 feet

FINISH:

AQUIFERS:

WATER LEVEL:

21 feet below surface

PUMPING EQUIPMENT: Type Gould jet H.P. 1
Capacity 17 G.P.M.

WELL TESTS:

Drawdown 160 ft. after _____ hours 120 G.P.M.
Drawdown _____ ft. after _____ hours _____ G.P.M.

USE OF WATER Irrigation Temp. _____ °F. _____, 19

SOURCE OF INFORMATION Well Registration Statement

DRILLER or DIGGER _____

ADDITIONAL DATA:

Log X Water Level Measurements _____ Chemical Analysis _____ Aquifer Test _____

REMARKS:

Log:	Thickness	Depth to Bottom
Rock and clay	261	
Soft lava	261-297	
Hard basalt	297-301	
Water bearing material	301-338	