

STATE ENGINEER
Salem, Oregon

WASH
4810

Well Record

STATE WELL NO. 1N/W-28.D(1)
COUNTY Washington
APPLICATION NO. GR-194


OWNER: Frederick E. Hartung

MAILING ADDRESS: 2300 N.W. 143 Ave.

LOCATION OF WELL: Owner's No. #1

CITY AND STATE: Portland, Oregon

NW $\frac{1}{4}$ NW $\frac{1}{4}$ Sec. 28 T. 1 N. 3, R. 1 W., W.M.

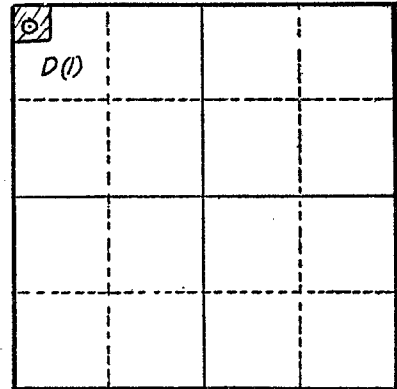

Bearing and distance from section or subdivision corner

Section 28

Altitude at well 273 feet Interpolated

TYPE OF WELL: Drilled Date Constructed 2/3/53

Depth drilled 753 Depth cased 600

CASING RECORD:

6 inch steel casing set from 0 to 600 feet.

FINISH:

None

AQUIFERS:

rock, from 60 to 753 feet.

WATER LEVEL:

Flowing Well - 30 gpm [#] 20 psi. 4/13/53

PUMPING EQUIPMENT: Type B-J made 1 KM - 12.0 WT ? H.P. 5

Capacity 60-80 G.P.M.

WELL TESTS:

Drawdown 240 ft. after hours pumping 84 G.P.M.

Drawdown 148 ft. after hours " 64 G.P.M.

USE OF WATER Irrigation 9.04 acres Temp. °F., 19

SOURCE OF INFORMATION Registration Statement GR-194

DRILLER or DIGGER

ADDITIONAL DATA:

Log yes Water Level Measurements Chemical Analysis Aquifer Test

REMARKS:

